


CERTIFIED RECORD OF LAND CORNER MONUMENTATION

History of original corner establishment:

Southwest 1/16 corner was established by R. Ware, RLS #1005, in 1980.

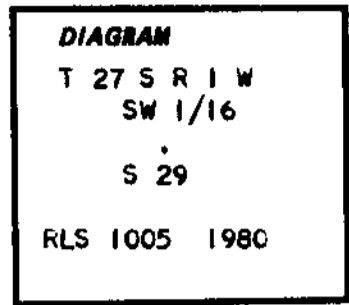

Description of corner evidence found:

14" Hemlock bears S 54° E, 32.2 feet, scribing visible.
8" Hemlock stump bears S 36° W, 8.4 feet, scribing visible.

2 1/2" Iron pipe with 3" brass cap

FILED

JH
MAY 29 1990

COUNTY SURVEYOR
DOUGLAS COUNTY, ORE.

Description of monument and accessories established to perpetuate the original location of this corner:

22" Hemlock bears N 47°30' E, 41.6 feet, inscribed "SW 1/16 S29 BT" alum. tag marked "ARTMAN RLS 2268" nailed flush to "BT" face.



Office of.....Surveyor..... County of.....Douglas.....
 State of.....Oregon....., I hereby certify that the within instrument was filed in this office
 for record on the...29... day of.....May..... 19.90
Fritz Ingram..... by *Virginia C. Layton*.....
 (COUNTY OFFICIAL) (DEPUTY)