


CERTIFIED RECORD OF LAND CORNER MONUMENTATION

History of original corner establishment:

Center-South 1/16 corner was established by R. Ware, RLS #1005, in 1980.

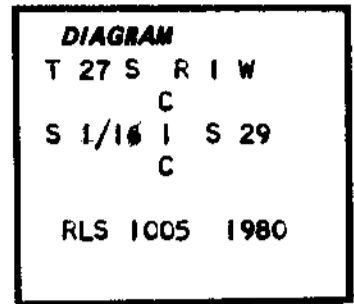

M 79-32

Description of corner evidence found:

2 1/2" iron pipe with 3" brass cap 14" above ground in a 30" diameter rock mound.

27" Cedar bears S 66° W, 16.2 feet, scribing visible.

FILED

fh

MAY 29 1990

COUNTY SURVEYOR
DOUGLAS COUNTY, ORE.

Description of monument and accessories I established to perpetuate the original location of this corner:

5" Hemlock bears N 22°30' E, 39.7 feet, I scribed "CS 1/16 S29 BT" alum. tag marked "ARTMAN RLS 2268" nailed flush to "BT" face.

REGISTERED
PROFESSIONAL
LAND SURVEYOR

J. D. Artman

OREGON
JULY 16, 1987
JAMES D. ARTMAN
2263

Office of.....Surveyor..... County of.....Douglas.....
State of.....Oregon....., I hereby certify that the within instrument was filed in this office
for record on the...29... day of.....May....., 19..90
.....Fritz Ingram..... by *Virginia O. Saenger*.....
(COUNTY OFFICIAL) (DEPUTY)