

FILED

OCT 2 1990

OREGON CORNER RESTORATION FORM

Section 31 Township 21S Range 9W

County DOUGLAS Date 9-5-90

COUNTY SURVEYOR
DOUGLAS COUNTY, ORE.

Corner Designation

W 1/4

- Condition Report Only
- Not Found
- Renewed
- Unrecorded
- Surveyed In
- Referenced Out


Previous Renewals/Surveys, etc. _____

Monument(s) & Accessories Found: (Condition and Source)

FOUND 1" I.P. WITH 2 1/2" BRASS CAP. I.P. HAD RUSTED IN TWO AT GROUND LEVEL.
FOUND A 58" CEDAR W/AXE MARKS. BRS. NOTE 47.94' TO SIDE CENTER.
FOUND A STUMP HOLE WHERE FIR B.T. WAS BLOWN OUT OF AND SLID DOWN HILL BRS. S76E 19.14' TO CENTER OF HOLE.

Monument Detail

Sketch

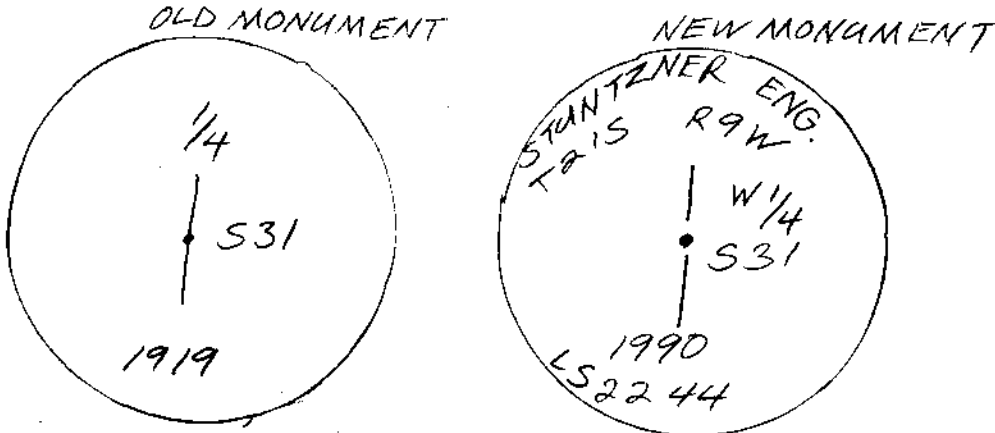

Monument Set (Procedures and Description)

SET A 2" ALU. CAP ON A 3/4" X 30" I.R. ALONG SIDE OLD MONUMENT.

NEW ACCESSORIES A 56" CEDAR W/FACE SCRIBED W 1/4 S31 BT AND TAG BRS. S25E 52.93' TO A SPIKE IN SIDE CENTER.
A 58" CEDAR W/FACE SCRIBED W 1/4 S31 BT AND TAG BRS. NOTE 47.94' TO A SPIKE IN SIDE CENTER.
A 13" ALDER W/BARK SCRIBE W 1/4 S31 BT AND TAG BRS. S62E 24.8' TO A SPIKE IN SIDE CENTER.
A 9" HEMLOCK W/FACE SCRIBED BT. X AT B.N. AND TAG BRS. S58E 32.23' TO A SPIKE IN SIDE CENTER.

Location & Comments

Surveyor's Seal

ABOUT 2 MILES UP WELLS CREEK TAKE SPUR TO THE WEST ABOUT 1 MILE TO POINT WHERE ROAD CROSSES LINE BETWEEN SEC. 36 AND SEC. 31

Compass Declination 19E.
 Firm/Agency STUNTZNER ENGINEERING
 Address BOX 118 COOSBAY OREGON 97420
 Party Chief J. ESTABROOK
 Notes _____
 Witness K. CLEVENGER

REGISTERED
PROFESSIONAL
LAND SURVEYOR

Harvey Wilcox

OREGON
JULY 17, 1986
HARVEY WILCOX
2244

#54 T21-9 X
#130 T21-10 X

C.S. File No. 63/104-25