

FILED

Handwritten initials

OCT 2 1990

OREGON CORNER RESTORATION FORM

Section 36 Township 21S Range 10W

County DOUGLAS Date 9-5-90

COUNTY SURVEYOR
DOUGLAS COUNTY, ORE.

Corner Designation

E 1/4

- Condition Report Only
- Not Found
- Renewed
- Unrecorded
- Surveyed In
- Referenced Out

Previous Renewals/Surveys, etc. _____



Monument(s) & Accessories Found: (Condition and Source)

FOUND 1" I.P. WITH 2 1/2" BRASS CAP. I.P. HAD RUSTED
IN TWO AT GROUND LEVEL.

FOUND A 48" FIR STUMP W/ OLD FACE AND VISIBLE
SCRIBE BRS N79W 50.02' TO CENTER OF STUMP.

Monument Detail

Sketch

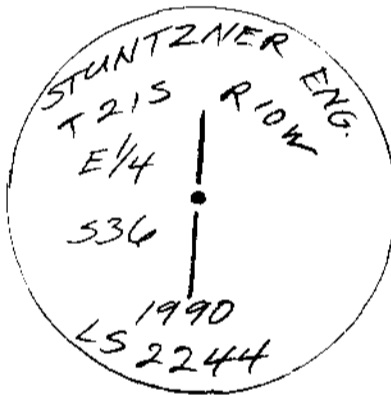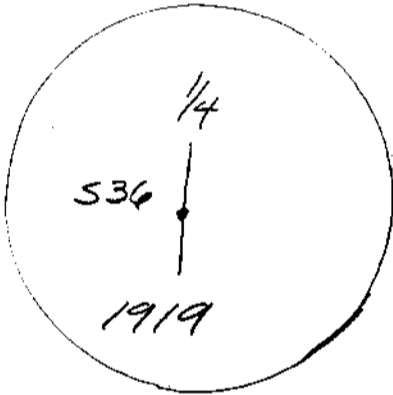

Monument Set (Procedures and Description)

SET A 2" ALU. CAP ON A 3/4" X 30" IR. ALONG SIDE
OLD MONUMENT

New Accessories A 24" HEMLOCK W/FACE SCRIBED E 1/4 536
 BT AND TAG BRS. N68E 38.5' TO SPIKE IN SIDE CENTER
 A 14" FIR W/FACE SCRIBED E 1/4 536 BT AND TAG
 BRS. S41E 11.7' TO A SPIKE IN SIDE CENTER.
 A 10 1/2" FIR W/FACE SCRIBED E 1/4 536 BT AND TAG
 BRS. S40W 23.5' TO A SPIKE IN SIDE CENTER.

Location & Comments

ABOUT 2 MILES Compass Declination 19E.
UP WELLS CREEK Firm/Agency STUNTZNER
TAKE SPUR TO THE ENGINEERING
WEST ABOUT 1 Address BOX 118 COOSBAY
MILE TO POINT OREGON 97420
WHERE ROAD Party Chief J. ESTABROOK
CROSSES LINE Notes _____
BETWEEN SEC. Witness K. CLEVINGER
36 AND SEC. 31

Surveyor's Seal

REGISTERED
PROFESSIONAL
LAND SURVEYOR

Harvey Wilcox
OREGON
JULY 17, 1985
HARVEY WILCOX
2244

55 T21-9
129 T21-10