


CERTIFIED RECORD OF LAND CORNER MONUMENTATION

History of original corner establishment:

L. Friar subdivided section 30 for the USFS in 1979 setting the SW 1/16 corner.

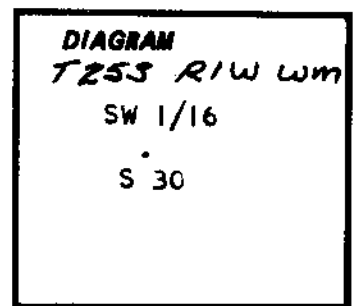

Description of corner evidence found:

2 1/2" iron pipe with 3" brass cap 3" above ground in a 36" diameter rock mound.

Description of monument and accessories established to perpetuate the original location of this corner:


8" D. Fir bears S 55° E, 7.8 feet, with healed blaze. (record S 35° E)  
24" D. Fir bears S 35° W, 7.7 feet, with healed blaze.

JAMES ARTMAN SURVEYING  
P.O. BOX 576  
WINSTON, OREGON 97496  
(503) 679-7176

FILED

*SL*  
OCT 2 1990

COUNTY SURVEYOR  
DOUGLAS COUNTY, ORE.

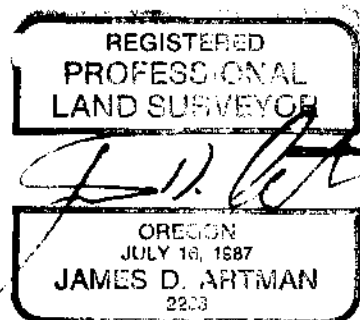

Office of Surveyor County of Douglas  
State of Oregon I hereby certify that the within instrument was filed in this office  
for record on the 2nd day of October, 19 90  
Fritz Ingram by *Virginia C. Saugen*  
(COUNTY OFFICIAL) (DEPUTY)