

OREGON CORNER RESTORATION FORM

Section: 26 Township: 31S Range: 4W

County: Douglas Date: 9/27/90

FILED

SL
OCT 2 1990

Corner Designation

COUNTY SURVEYOR
DOUGLAS COUNTY, ORE.

1/4 sec. cor. of secs. 25 and 26

Previous Renewals/Surveys, etc.: Original Section Subdivision of 1893, BLM Survey of 1980.

Monument(s) & Accessories Found:

Found: iron post, 2 1/2 ins. diam. with brass cap mkd.


T 31 S R 4 W
1/4
S 26 | S 25
1980

Found: Original B.T., 40.6" DBH DF, bears S67 3/4°E, 7 1/2 lks. dist., with healed blaze.

Found: Rotten stump of original B.T., bears N25 3/4°W, 17 lks., old slab is now detached from stump, but scribing is evident.

Found: BLM B.T. 6" DF (1980), bears N27°W, 21 lks dist., mkd. 1/4 S26 BT, now laying approx. N10°W.

Monument Detail:

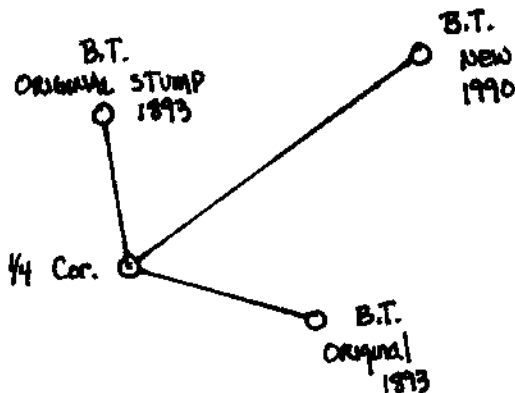

Monument Set:

N/A

New Assessories:

Set: New bearing tree, 8.2" DBH DF, bears N45°30'E, 23.0 ft. dist., with blaze scribed 1/4 LS 749 BT.

Location and comments:

No acceptable bearing trees found in section 26.
Corner lies on W facing slope approx. 100' W of road (31-4-27).
Compass Declination: 19°30'E.
Firm: Gregory Forest Products.
Address: P.O. Box C, Glendale, OR 97442.
Party Crew: Buck Mehl, Doug Thackery, Dave Krueger, Pat Fadden, Mark Nicholson.

Surveyor's Seal



#179 ✓

C.S. File No. 63/104-29