

FILED *JP*

OREGON CORNER RESTORATION FORM

Section 25 Township 21S Range 5W

OCT 12 1990

County Douglas Date 10-04-90

COUNTY SURVEYOR

CORNER DESIGNATION

South  $\frac{1}{4}$  Corner  
Section 25

- DOUGLAS COUNTY, ORE. Condition Report Only
- Not Found
  - Renewed
  - Unrecorded
  - Surveyed In
  - Referenced Out


Previous Renewals/Surveys, etc. Original G.L.O. Survey by Gordon and Gardner in 1855 and Survey M79-69 by Roderick Kimberling in 1981

Monument(s) & Accessories Found: (Condition and Source)

18" Fir Stump, S10W, 16.5' (Scribing  $\frac{1}{4}$  S Visible), 1855 B.T.  
N.E. Bearing tree could not be found.

Monument Detail

Sketch

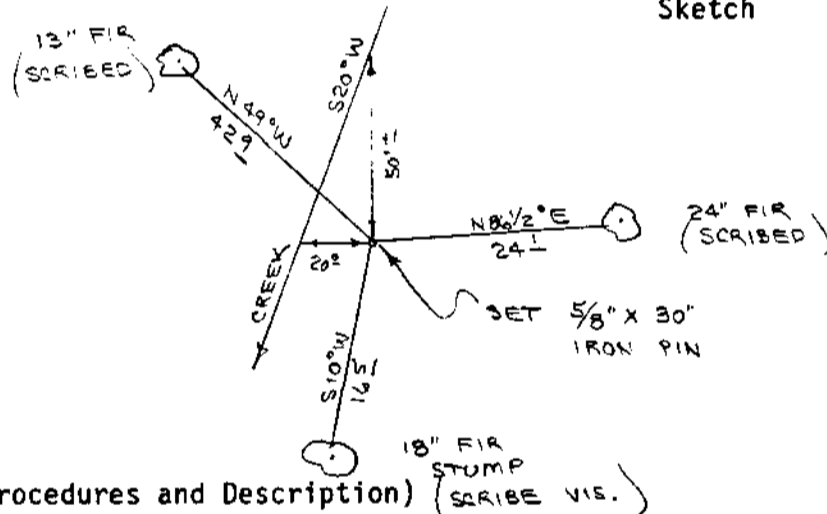

Monument Set (Procedures and Description) (SCRIBE VIS.)

Set 5/8" iron pin with yellow plastic cap. Cap marked "Roberts P.L.S. 1039". Iron pin is 30" long.

New Accessories

- 13" Fir, N49W, 42.9' (Scribed/Painted Red)
- 24" Fir, N86 1/2 E, 24.1' (Scribed/Painted Red)

Location & Comments

Corner lies about 20'  
East of small draw. Draw  
bears S20W and N20E.

Compass Declination 20 1/2  
 Firm/Agency Roberts  
Surveying Inc.  
 Address 29 West 29th Street  
Eugene, Oregon 97405  
 Party Chief Ted Baker  
 Notes Harvey Christensen  
 Witness \_\_\_\_\_

Surveyor's Seal



#175 *J*