

FILED


NOV 5 1990

OREGON CORNER RESTORATION FORM

Section 24 Township 22S Range 7W
County DOUGLAS Date 3/90

COUNTY SURVEYOR
DOUGLAS COUNTY, ORE.

Corner Designation

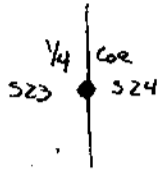

- Condition Report Only
- Not Found
- Renewed
- Unrecorded
- Surveyed In
- Referenced Out

Previous Renewals/Surveys, etc. _____

Monument(s) & Accessories Found: (Condition and Source)


CORNER IS A 2 1/2" IRON POST WITH BLM BRASS CAP, AND A T-IRON SET BY HAWES ON NORTH EDGE OF CAP.

✓ 16" CEDAR BEARS S55°W 3.2 FT. WITH A WELL HEALED FACE AND BLM B.T. TAG. (ORIGINAL B.T.)

Ren# 129 - 9" DOUGLAS FIR BEARS N32 1/2° E 17.2 FT. WITH WELL HEALED FACE. TAGGED TREE WITH A LONE ROCK TIMBER LOCATION TAG, WITH ABOVE INFORMATION.

Monument Detail

Sketch

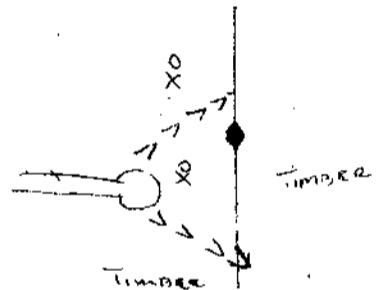

Monument Set (Procedures and Description)

New Accessories

WE PAINT ALL B.T. FACES AND WRITE B.T. ON TRUNKS OF ALL B.T.S. WITH FLOUR ORANGE PAINT.

Location & Comments

CORNER SITS ON STEEP N.W. SLOPE AT BOTTOM OF CLEAR CUT ABOUT 20 FT. NORTH OF SLUMP AREA

Compass Declination 19 1/2°
Firm/Agency LONE ROCK TIMBER COMPANY
Address P.O. BOX 1127 ROSEBURG
Party Chief KEN HOFFINE
Notes _____
Witness GARY ANGIOLET

Surveyor's Seal

