

FILED
JK

OREGON CORNER RESTORATION FORM


Section 26 Township 22S Range 7W

NOV 5 1990

County Douglas Date 3/90

COUNTY SURVEYOR
DOUGLAS COUNTY, ORE.

Corner Designation

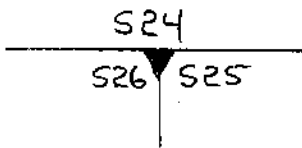

- Condition Report Only
- Not Found
- Renewed
- Unrecorded
- Surveyed In
- Referenced Out


Previous Renewals/Surveys, etc. _____

Monument(s) & Accessories Found: (Condition and Source)

- #57 → Corner is a 1" x 1" Haines Iron T-Bar in good condition
- 33" DF bears S59°E, 33.2 FT, well healed with BLM and County bearing Tree Tags - Original B.T.
- 62" DF bears S85°W, 26.2 FT with a healed face, BLM and County bearing Tree Tags - Original B.T.
- Ren # 173 → - 23" DF bears S40°W, 57.2 FT, well healed with County Tag

Monument Detail

Sketch

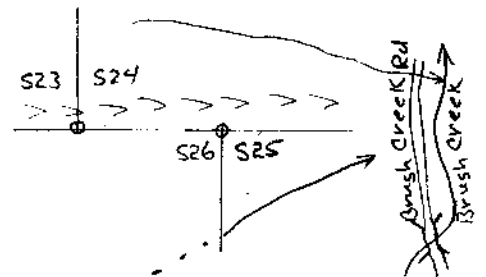

Monument Set (Procedures and Description)

New Accessories

I paint healed faces and paint B.T. on Tree Trunks with Flour, red paint.

Location & Comments

Corner lies near
 base of 30" DF on
 south facing slope
 100 FT South of
 Top spur ridge and
 approx 5 chains west
 of Brush Creek Main-
 line Road.

Compass Declination 19 1/2°
 Firm/Agency Lone Rock
Timber Co
 Address PO Box 1127
Roseburg
 Party Chief Ken Hoffine
 Notes _____
 Witness Gary Angiolet

Surveyor's Seal

REGISTERED
 PROFESSIONAL
 LAND SURVEYOR

Ken Hoffine

OREGON
 JULY 18, 1987
 KEN W. HOFFINE
 2281