

OREGON CORNER RESTORATION FORM

FILED

NOV 5 1990

Section 22 Township 23S Range 4W

County DOUGLAS Date 1/90

COUNTY SURVEYOR
DOUGLAS COUNTY, ORE.

Corner Designation

T23S R4W
S21 | S22
S28 | S27

- Condition Report Only
- Not Found
- Renewed
- Unrecorded
- Surveyed In
- Referenced Out


Previous Renewals/Surveys, etc. _____

Monument(s) & Accessories Found: (Condition and Source)

CORNER IS A 2 1/2" BRASS CAP 0.2 FT ABOVE GROUND IN GOOD CONDITION
 12" D.F. BEARS N62°W 45.9 FT WELL HEALED FACE AND B.T. TAG
 10" D.F. BEARS S66°W 43.1 FT WELL HEALED FACE AND B.T. TAG
 30" D.F. BEARS S50°E 18.2 FT WELL HEALED FACE AND B.T. TAG
 32" D.F. BEARS N88°E 13.0 FT WELL HEALED FACE AND B.T. TAG

Monument Detail

Sketch

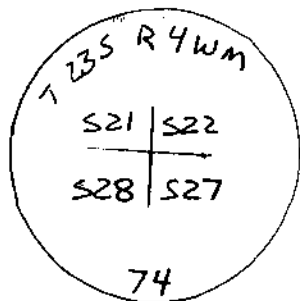

Monument Set (Procedures and Description)

New Accessories

PAINTED ALL FACES AND WROTE B.T. ON TREE TRUNKS OF ALL B.T.'S WITH FLOUR ORANGE PAINT

Location & Comments

CORNER LIES ON 20% SOUTH SLOPE WITH SMALL TIMBER THERE IS A FIELD TO THE SOUTH - EAST

Compass Declination N 1/2°
 Firm/Agency LOWE ROCK TIMBER COMPANY
 Address P.O. BOX 1127

Party Chief KEN HOFFINE
 Notes _____
 Witness GARY ANGIOLLI

Surveyor's Seal

