

OREGON CORNER RESTORATION FORM

FILED

zh

Section 22 Township 235 Range 4W

NOV 5 1990

County DOUGLAS Date 6/90

COUNTY SURVEYOR
DOUGLAS COUNTY, ORE.

Corner Designation

S21 | S22
S28 | S27

- Condition Report Only
- Not Found
- Renewed
- Unrecorded
- Surveyed In
- Referenced Out

Previous Renewals/Surveys, etc.



Rein # 150 →
Rec. SW

Monument(s) & Accessories Found: (Condition and Source)

- CORNER IS A BRASS CAP SET BY SHAWAR IN GOOD CONDITION
- 10" D.F. BEARS S66°W 43.1 FT, WALL HEALED FACE AND B.T. TAG
- 14" D.F. BEARS N62°W 45.9 FT, WALL HEALED FACE AND B.T. TAG
- 36" D.F. BEARS N88°E 13.0 FT, WALL HEALED FACE AND B.T. TAG
- 34" D.F. BEARS S50°E 18.2 FT, WALL HEALED FACE AND B.T. TAG

Monument Detail

Sketch

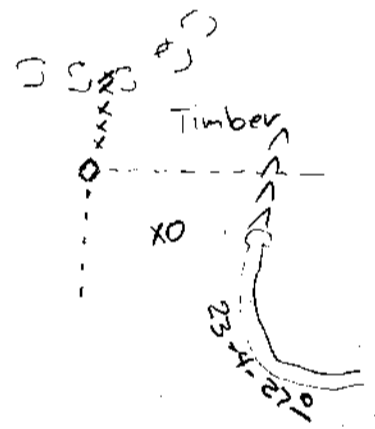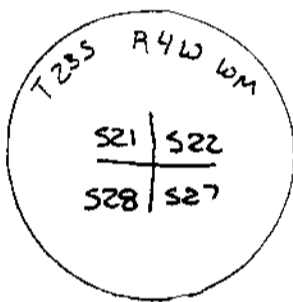

Monument Set (Procedures and Description)

New Accessories

PAINTED FACES AND WROTE B.T. ON TREE TRUNKS OF B.T. TREES WITH FLOUR ORANGE PAINT

Location & Comments

CORNER LIES AT NW
CORNER OF BLM
CLEARCUT ON SMALL
FLAT AT BOTTOM OF
SOUTH AND WEST
FACING SLOPES

Compass Declination 19 1/2°
Firm/Agency LOWE ROCK
TIMBER COMPANY
Address P.O. BOX 1127
ROSEBURG
Party Chief KEN HOFFINE
Notes
Witness GARY ANGIOLET

Surveyor's Seal

REGISTERED
PROFESSIONAL
LAND SURVEYOR

Ken W Hoffine

OREGON
JULY 18, 1987
KEN W. HOFFINE
2291