

FILED

OREGON CORNER RESTORATION FORM

Section 5 Township 23S Range 5W

NOV 5 1990

County DOUGLAS Date _____

COUNTY SURVEYOR
DOUGLAS COUNTY, ORE

Corner Designation

T23S R5W	
S 6	SS
S 7	S 8

- Condition Report Only
- Not Found
- Renewed
- Unrecorded
- Surveyed In
- Referenced Out



Previous Renewals/Surveys, etc. _____

Monument(s) & Accessories Found: (Condition and Source)

- #18 → CORNER IS A 1 1/4" IRON POST WITH BRASS CAP IN GOOD CONDITION
- BLM 1982 ✓ 16" OAK BEARS N 18° W 247.3 FT. SCREWS VISIBLE, AND BLM B.T. TAG.
- #18 ✓ 24" BOTTEN FIB STUMP BEARS S 13° E 45 FT. HAS BLM B.T. TAG.
- BLM ✓ 9" D.F. BEARS S 46° E 25.0 FT. WELL HEALED FACE, & BLM B.T. TAG.
- Rec. 79 FT → 21" OAK BEARS S 10° W 72.0 FT. WELL HEALED FACE, AND BLM B.T. TAG.
- #18 ✓ 24" OAK BEARS N 24° E 71.1 FT. WELL HEALED FACE AND BLM B.T. TAG.

Monument Detail

Sketch

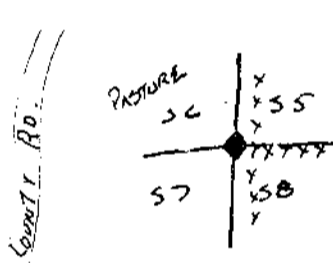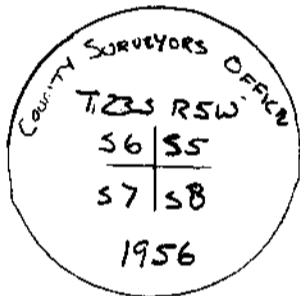

Monument Set (Procedures and Description)

New Accessories

I PAINT FACES AND WRITE B.T. ON TREE TRUNKS OF ALL
 B.T.'S WITH FOUR ORANGE PAINT.

Location & Comments

CORNER LIES ON EAST COMPASS DECLINATION 19 1/2°
 SLOPE OF PASTURE FIRM/AGENCY LOWE ROSS
 APPROX. 16 FT. WEST TIMBER COMPANY
 OF FENCE CORNER, ADDRESS P.O. BOX 1127
 WHERE I PUT LOCATION ROSEBURG
 TAG. PARTY CHIEF KEN HOFFINE
 Notes _____
 Witness _____

Surveyor's Seal

