


OREGON CORNER RESTORATION FORM  
 Section X 6 Township 23S Range 5W  
 County DOUGLAS Date 6/90

FILED  
 NOV 5 1990

COUNTY SURVEYOR  
 DOUGLAS COUNTY, ORE.

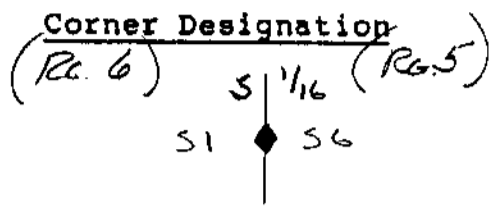

- Condition Report Only
- Not Found
- Renewed
- Unrecorded
- Surveyed In
- Referenced Out


Previous Renewals/Surveys, etc. \_\_\_\_\_

Monument(s) & Accessories Found: (Condition and Source)

No Record →  
 HAINES  
 M 48-3

CORNER IS A 1 1/2" IRON POST WITH BRASS CAP.  
 14" CEDAR BEARS NS2°W 6.3 FT WELL HEALED FACE AND  
 BLM B.T. TAG  
 32" CEDAR BEARS N19 1/2° E 25.3 FT WELL HEALED FACE AND  
 BLM B.T. TAG

Monument Detail

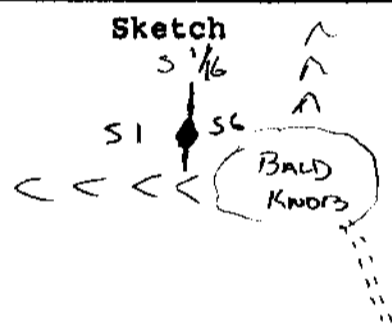

Monument Set (Procedures and Description)

New Accessories

WE PAINT FACES AND WRITE B.T. ON TRUNK OF ALL  
 B.T.'S WITH FLOO. ORANGE PAINT

Location & Comments

CORNER SITS ON STEEP Compass Declination 19 1/2°  
 WESTEALY SLOPE 2 CHAINS Firm/Agency LOVE ROCK  
 WEST OF BALD KNOPS. TIMBER COMPANY  
 THERE IS A BLM BOUNDARY Address P.O. Box 1127  
 LINE RUNNING SOUTH. ROSEBURG, OR  
 AND BLM BOUNDARY TAGS Party Chief KEN HOFFINE  
 RUNNING WEST FROM Notes \_\_\_\_\_  
 CORNER. Witness GARY ANGLETT

Surveyor's Seal



#81 T23-6 x  
 #130 T23-5 x