

FILED

NOV 5 1990


OREGON CORNER RESTORATION FORM

Section 12 Township 23S Range 6W

County DOUGLAS Date 3/90

COUNTY SURVEYOR
DOUGLAS COUNTY, ORE.

Corner Designation

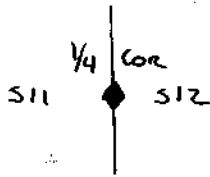

- Condition Report Only
- Not Found
- Renewed
- Unrecorded
- Surveyed In
- Referenced Out


Previous Renewals/Surveys, etc. _____

Monument(s) & Accessories Found: (Condition and Source)

- ✓ CORNER A 1" IRON POST WITH BRASS CAP
- ✓ 34" D.F. STUMP TREATED AND TINNED BEARS N35°W 64.2 FT HAS BLM B.T. TAG
- BLM REC. N7E → 40" D.F. BEARS N7°W 64.2 FT WITH BLM B.T. TAG.
- NO REC - 11" D.F. 76°W 10.5 FT. NO VISIBLE SCRIBINGS AND A BLM LINE CROSSING TAG
- " A METAL FRANCE POST BEARS EAST 1 FT.

Monument Detail

Sketch

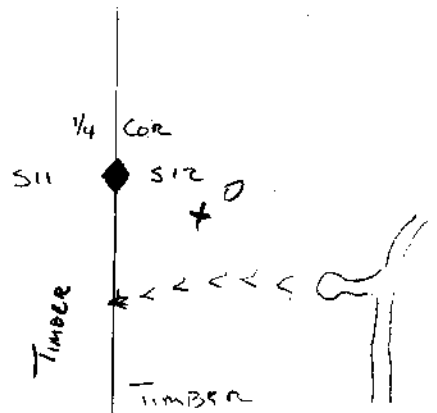

Monument Set (Procedures and Description)

New Accessories

WE PAINTED FACES AND WROTE B.T. ON TRUNKS OF ALL B.T.'S WITH FLUOR ORANGE PAINT

Location & Comments

CORNER LIES ON STEEP SLOPE MID-WAY DOWN WEST EDGE OF BLM CLEAR CUT

Compass Declination 19 1/2°
 Firm/Agency LONG ROCK TIMBER COMPANY
 Address P.O. BOX 1127 673-0141
 Party Chief KEN HOFFINE
 Notes _____
 Witness GARY ANDSILET

Surveyor's Seal

