

FILED

SH

NOV 5 1990


OREGON CORNER RESTORATION FORM

Section 16 Township 23S Range 6W

County DOUGLAS Date 3/90

COUNTY SURVEYOR
DOUGLAS COUNTY, ORE.

Corner Designation

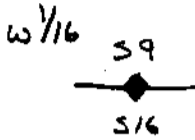

- Condition Report Only
- Not Found
- Renewed
- Unrecorded
- Surveyed In
- Referenced Out


Previous Renewals/Surveys, etc. _____

Monument(s) & Accessories Found: (Condition and Source)

- CORNER IS A BLM BRASS CAP 1.3 FT ABOVE GROUND IN GOOD CONDITION
- No Rec.* HAINES T-IRON BEARS N23°W 3.3 FT FROM BRASS CAP
- 21" D.F. STUMP THAT HAS HAD BARK REMOVED, TREATED, AND COVERED WITH TIN BEARS N68°W 26.5 FT; NO VISIBLE MARKS, I TAG.
- No Rec.* 26" D.F. STUMP THAT HAS HAD BARK REMOVED, TREATED, AND COVERED WITH TIN BEARS N50°W 24.8 FT NO VISIBLE MARKS, I TAG

Monument Detail

Sketch

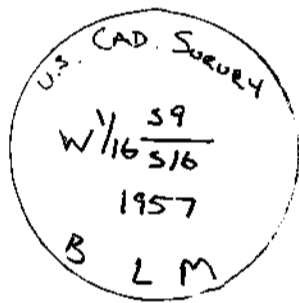

Monument Set (Procedures and Description)

New Accessories

Location & Comments

CORNER SITE 25 FEET
 ABOVE HIGH CUTDANK
 EAST OF BRUSH CREEK
 ROAD

Compass Declination 19 1/2°

Firm/Agency LONG ROCK
TIMBER COMPANY

Address P.O. BOX 1127
ROXBURG

Party Chief KEN HOFFINE

Notes _____

Witness _____

Surveyor's Seal

