

FILED

JH

NOV 5 1990

OREGON CORNER RESTORATION FORM

Section 18 Township 23S Range 6W

County DOUGLAS Date 5/90

COUNTY SURVEYOR
DOUGLAS COUNTY, ORE.

Corner Designation

T23S R6W

57 | 58

517 | 518


- Condition Report Only
- Not Found
- Renewed
- Unrecorded
- Surveyed In
- Referenced Out

Previous Renewals/Surveys, etc. _____


Monument(s) & Accessories Found: (Condition and Source)

- ✓ CORNER IS A BLM BRASS CAP IN GOOD CONDITION
- REN. # 23 → HAINES T-IRON BEARS S16°E 14.6 FT
- 1957 BLM ✓ 12" D.F. SWAG BEARS N18°W 37.5 FT; WELL HEALED FACE AND B.T. TAG (NO INFO)
- ✓ 23" D.F. BEARS N19°E 29.0 FT; WELL HEALED FACE NO B.T. TAG
- ✓ 24" D.F. BEARS S66°E 44.1 FT; WELL HEALED FACE AND B.T. TAG (NO INFO)
- ✓ 17" D.F. BEARS S25°W 23.3 FT; WELL HEALED FACE AND B.T. TAG (NO INFO)

Monument Detail

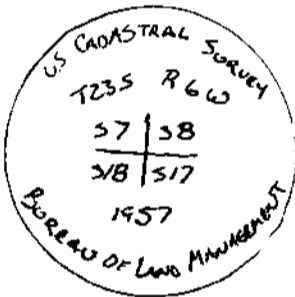

Sketch

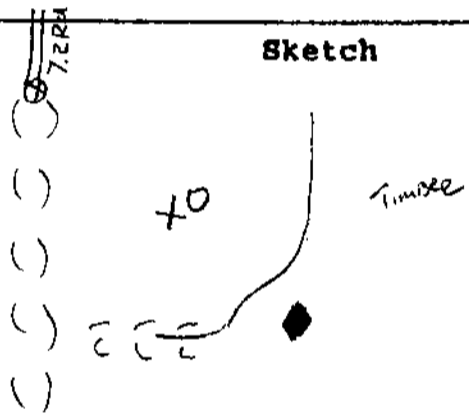

Monument Set (Procedures and Description)

New Accessories

PAINTED FACES AND WROTE B.T. ON TREE TRUNKS OF B.T.'S WITH FLOOR ORANGE PAINT
 PUT UP LONG ROCK TIMBER LOCATION TAG ON AN 18" D.F. BEARING N47°W 34.9 FT

Location & Comments

CORNER SITS ON EXTREMELY STEEP S.W. SLOPE AT HEAD OF OLD SCUMP. BLM CLEARCUT LIES APPROX 100 FT TO THE NORTH
 Compass Declination 17 1/2°
 Firm/Agency BONE ROCK TIMBER COMPANY
 Address P.O. BOX 1127 ROSEBURG
 Party Chief KEN HOFFINE
 Notes _____
 Witness GARY ANSDOLET

Surveyor's Seal

REGISTERED
PROFESSIONAL
LAND SURVEYOR

Ken W. Hoffine
 OREGON
 JULY 16, 1987
 KEN W. HOFFINE
 2291