

FILED

JH

OREGON CORNER RESTORATION FORM

NOV 5 1990

Section 18 Township 23S Range 6W COUNTY SURVEYOR

County Douglas Date 3/90

DOUGLAS COUNTY, ORE.

Corner Designation

T23S R6W

S7 | S8

S17 | S18

- Condition Report Only
- Not Found
- Renewed
- Unrecorded
- Surveyed In
- Referenced Out

Previous Renewals/Surveys, etc.

Monument(s) & Accessories Found: (Condition and Source)

CORNER IS A HAINES T-IRON IN GOOD CONDITION

BLM BRASS CAP FOR SECTION CORNER OF 718 BEARS N16°W 14.6 FT


22" DF BEARS N50°E 10.5 FT BARK SCRIBED AND HAINES BRASS WASHER

33" DF BEARS S52°E 15.4 FT BARK SCRIBED AND HAINES BRASS WASHER

32" DF BEARS S56°W 17.9 FT BARK SCRIBED AND HAINES BRASS WASHER

17" DF BEARS N37°W 48 2/3 FT WELL HEALED FACE AND HAINES BRASS WASHER

Monument Detail

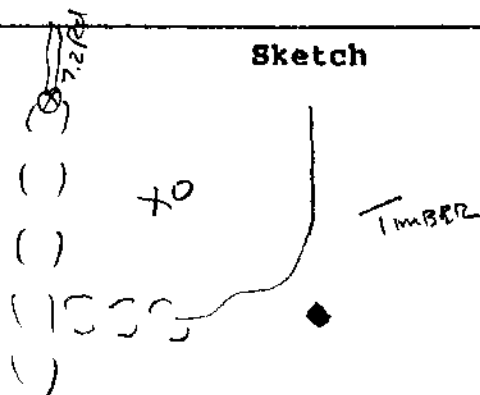

Monument Set (Procedures and Description)

New Accessories

PAINTED FACES AND WROTE B.T. ON TREE TRUNK OF B.T.'S WITH FLOOR ORANGE PAINT

Location & Comments

CORNER SITS ON A S.W. SLOPE AT HEAD OF OLD SLUMP. CORNER IS ON A MOUND OF ROCK AT TOP OF HEAD WALL

Compass Declination 19 1/2

Firm/Agency LOWE ROCK TIMBER COMPANY

Address P.O. BOX 1127 ROSEAURG

Party Chief KEN HOFFINE

Notes

Witness GARY ANGIOLET

Surveyor's Seal

