

FILED

NOV 5 1990

OREGON CORNER RESTORATION FORM

Section 24 Township 23S Range 6W COUNTY SURVEYOR  
County DOUGLAS Date 6/90 DOUGLAS COUNTY, ORE.

Corner Designation

CENTER 1/4 S 24



- Condition Report Only
- Not Found
- Renewed
- Unrecorded
- Surveyed In
- Referenced Out

Previous Renewals/Surveys, etc. \_\_\_\_\_

Monument(s) & Accessories Found: (Condition and Source)

Ren. # 36


CORNER IS A HAINES T-IRON 1.5 FT ABOVE GROUND 1.2 FT N10W OF  
OF NAIL IN ROTTEN LOG FOR TRUE CORNER POSITION.

20" D.F BEARS S90W 22.3 FT WELL HEALED FACE AND B.T. TAG

32" D.F BEARS S68E 30.5 FT, WALL HEALED FACE AND B.T. TAG

Monument Detail

Sketch

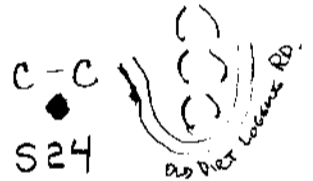

Monument Set (Procedures and Description)

\_\_\_\_\_  
\_\_\_\_\_  
\_\_\_\_\_

New Accessories

New Corner →

PAINTED FACES AND WROTE B.T. ON TREE TRUNKS OF B.T.'S  
WITH FLUOR ORANGE PAINT  
PUT METAL FENCE POST IN AT TRUE CORNER LOCATION 12 FT  
SIDE OF HAINES T-IRON.

Location & Comments

CORNER LIES ON SMALL  
NORTHWESTERLY SIDE  
RIDGE, JUST WEST OF  
VERY STEEP SLOPE LEADING  
TO FLAT RIDGE TOP  
WITH OLD DIRT  
LOSSING ROAD.

Compass Declination 19 1/2°  
Firm/Agency LOWE ROCK  
TIMBER COMPANY  
Address P.O. BOX 1127  
ROSEBURG  
Party Chief KEN HOFFINE  
Notes \_\_\_\_\_  
Witness GARY ANDERSON

Surveyor's Seal

REGISTERED  
PROFESSIONAL  
LAND SURVEYOR

*Ken W. Hoffine*

OREGON  
JULY 16, 1987  
KEN W. HOFFINE  
2291

#85 X  
#84

C.S. File No. 63/104-58