

FILED *rh*

OREGON CORNER RESTORATION FORM


Section 35 Township 26S Range 8W

NOV 5 1990

County DOUGLAS Date 3/90

COUNTY SURVEYOR  
DOUGLAS COUNTY, ORE.

Corner Designation

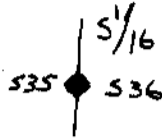

- Condition Report Only
- Not Found
- Renewed
- Unrecorded
- Surveyed In
- Referenced Out


Previous Renewals/Surveys, etc. \_\_\_\_\_

Monument(s) & Accessories Found: (Condition and Source)

CORNER IS A BRASS CAP 0.5 FT ABOVE GROUND IN GOOD CONDITION  
12" D.F. BEARS N.29° W 29.2 FT; WELL HEALED FACE AND B.T. TAG  
14" D.F. BEARS S45 1/2° E 23.2 FT; WELL HEALED FACE, I PUT UP B.T. TAG

Monument Detail

Sketch

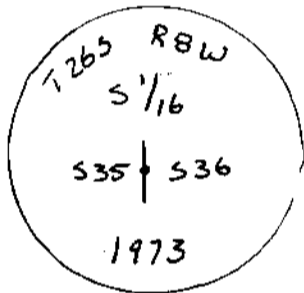

Monument Set (Procedures and Description)

\_\_\_\_\_  
 \_\_\_\_\_  
 \_\_\_\_\_  
 \_\_\_\_\_

New Accessories

PAINTED FACE AND WROTE B.T. ON TREE TRUNKS OF ALL B.T.'S  
WITH FLUOR ORANGE PAINT

Location & Comments

CORNER LIES ON EASY  
SOUTHERLY 2.0% SLOPE  
REDDEN TO THE EAST AND  
TIMBER TO THE WEST

Compass Declination 19 1/2°  
 Firm/Agency LOWE ROCK  
TIMBER COMPANY  
 Address P.O. Box 1127  
ROSEBURG  
 Party Chief KEN HOFFINE  
 Notes \_\_\_\_\_  
 Witness GARY ANGIOLUET

Surveyor's Seal

REGISTERED  
PROFESSIONAL  
LAND SURVEYOR

*Ken W Hoffine*

OREGON  
JULY 16, 1987  
KEN W. HOFFINE  
2291