

FILED

7/8

NOV 16 1990

OREGON CORNER RESTORATION FORM

Section 12 Township 31 S Range 5 W

County Douglas Date 11/15/90

COUNTY SURVEYOR
DOUGLAS COUNTY, ORE.

Corner Designation

E 1/16 S 12
 S 13



- Condition Report Only
- Not Found
- Renewed
- Unrecorded
- Surveyed In
- Referenced Out

Previous Renewals/Surveys, etc. Corner set by B.L.M. 1973 in a Dependent Resurvey, Portion of Subdivisional Lines, T. 31 S., R. 5 W., W.M.

Monument(s) & Accessories Found: (Condition and Source) Found B.L.M. Brass Cap in good condition. Bearing trees have been pulled over by logging activity.

Monument Detail

Sketch NO SCALE

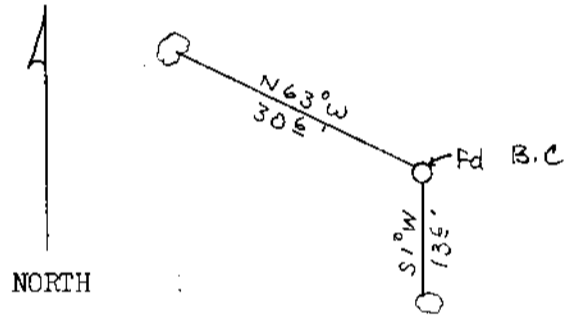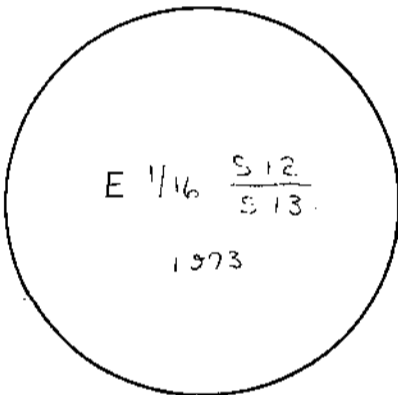

Monument Set: (Procedures and Description) N/A

New Accessories New Bearing Trees

1. A Fir, 8" diam., Bears S 1° W, 13.6 ft. dist., mkd. E 1/16, S 13, BT.
2. A Fir, 6" diam., Bears N 63° W, 30.6 ft. dist., mkd. E 1/16, S 12, BT.

Location & Comments

Corner located on South end of logged unit.

Compass Declination 19° E

Firm/Agency PLS 2391
Raymond F. Brown

Address P.O. Box 539
Canyonville, OR. 97417

Party Chief R. Brown

Notes B. Ike

Witness J. Haight

Surveyor's Seal

REGISTERED
PROFESSIONAL
LAND SURVEYOR

Raymond F. Brown

OREGON
JULY 26, 1989
RAYMOND F. BROWN
2391