


CERTIFIED RECORD OF LAND CORNER MONUMENTATION

History of original corner establishment:

General Land Office Survey by E. Worth 1917

Douglas County Surveyors Office Re-establishment 1969

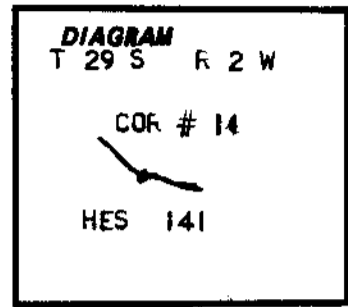

Description of corner evidence found:

1" iron pipe with 2 1/2" brass cap 12" above ground set on the Southwest side of an Ash stump

- 20" Ash stump (original corner tree)
- 36" D. Fir bears N 9° 15' E, 31.7 feet, with healed blaze
- 14" W. Fir (down and rotted) bears N 37° 45' E, 20.5 feet

FILED

NOV 26 1990

COUNTY SURVEYOR
DOUGLAS COUNTY, ORE.

Description of monument and accessories I established to perpetuate the original location of this corner:

Set a 5/8"x30" iron rod with a 1" yellow plastic cap 27" in the ground, marked "ARTMAN RLS 2268" for reference monument, bears S 58° 30' E, 20.0 feet.

Painted corner tree and tagged all Bts, Set 6' aluminium post alongside iron rod with 54-2, 54-9, and 54-3 signs attached.

JAMES ARTMAN SURVEYING
PO BOX 576
WINSTON OREGON 97496
503 679-7176

REGISTERED
PROFESSIONAL
LAND SURVEYOR

OREGON
JULY 16, 1987
JAMES D. ARTMAN
2268

Office of..... Surveyor..... County of..... Douglas.....
State of..... Oregon....., I hereby certify that the within instrument was filed in this office
for record on the 26... day of..... November....., 19..90
..... Fritz Ingram..... by..... *Virginia C. Sengen*.....
(COUNTY OFFICIAL) (DEPUTY)

#123 ✓