


CERTIFIED RECORD OF LAND CORNER MONUMENTATION

History of original corner establishment:

General Land Office Survey by E. Worth in 1917

Douglas County Surveyors Office Re-establishment in 1969

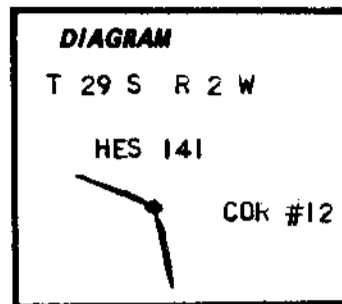

FILED *JP*

Description of corner evidence found:

1" iron pipe with a 2 1/2" brass cap 12" above ground

30" W. Fir stump bears S 3° 30' E, 17.2 feet (rotted)

28" W. Fir stump bears S 37° 30' W, 22.4 feet (rotted)

16" W. Fir (snag) bears S 57° W, 24.0 feet, with healed blaze

NOV 26 1990

COUNTY SURVEYOR  
DOUGLAS COUNTY, ORE.

Description of monument and accessories established to perpetuate the original location of this corner:

16" Yewood bears S 64° W, 11.8 feet scribed " 12 HES 141 BT " with alum. tag marked "ARTMAN RLS 2268" nailed flush to bt face.

9" Yewood bears ~~N 37° E~~, 23.0 feet scribed " 12 HES 141 BT " with alum. tag marked "ARTMAN RLS 2268" nailed flush to bt face.

Painted and tagged all Bts

JAMES ARTMAN SURVEYING  
PO BOX 576  
WINSTON OREGON 97496  
503 679-7176

REGISTERED  
PROFESSIONAL  
LAND SURVEYOR

OREGON  
JULY 15, 1987  
JAMES D. ARTMAN

Office of..... Surveyor..... County of..... Douglas.....

State of..... Oregon..... I hereby certify that the within instrument was filed in this office

for record on the... 26... day of... November....., 1990.

..... Fritz Ingram..... by *Fritz Ingram*.....

(COUNTY OFFICIAL)

(DEPUTY)

#124 ✓