


CERTIFIED RECORD OF LAND CORNER MONUMENTATION

History of original corner establishment:

General Land Office Survey by E. Worth in 1917

Douglas County Surveyors Office Re-establishment in 1969

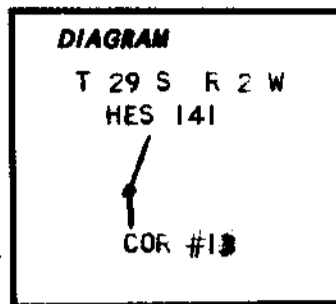

FILED *p*

NOV 26 1990

Description of corner evidence found:

1" iron pipe with 2 1/2" brass cap 17" above ground

Remains of well rotted W. Fir bear N 58° 30' E, 17.2 feet

Remains of well rotted W. Fir bear S 54° E, 13.9 feet

14" W. Fir (snag top) bears S 13° W, 21.5 feet with healed blaze

15" Pine (snag) bears N 43° E, 32.8 feet, with healed blaze

COUNTY SURVEYOR  
DOUGLAS COUNTY, ORE.

Description of monument and accessories I established to perpetuate the original location of this corner:

10" W. Fir bears S 7° E, 18.8 feet, scribed " 13 HES 141 BT " with alum. tag marked "ARTMAN RLS 2268" nailed flush to Bt face.

14" W. Fir bears S 38° E, 27.1 feet scribed " 13 HES 141 BT " with alum. tag marked "ARTMAN RLS 2268" nailed flush to Bt face.

Painted and tagged all Bts

JAMES ARTMAN SURVEYING  
PO BOX 576  
WINSTON OREGON 97496  
503 679-7176



Office of..... Surveyor..... County of..... Douglas.....  
 State of..... Oregon....., I hereby certify that the within instrument was filed in this office  
 for record on the.....26..... day of..... November....., 1990  
 Francis Ingram..... by Virginia C. Rangen.....  
 (COUNTY OFFICIAL) (DEPUTY)

#125-X