

FILED

*Handwritten initials*

NOV 30 1990

OREGON CORNER RESTORATION FORM

Section 15 Township 28 S Range 4 W

County Douglas Date 11/15/90

COUNTY SURVEYOR  
DOUGLAS COUNTY, ORE.

Corner Designation

Northwest corner of private land.  
( Corner number 2 )

- Condition Report
- Not Found
- Renewed
- Unrecorded
- Surveyed In
- Referenced Out


Previous Renewals / Surveys, etc. Corner No. 2 ( ES-2-979 )

Monument(s) & Accessories Found: (Condition and Source) From notes furnished by P.L.M.  
Found 1 1/2" iron pipe at corner.


Accessories Found ( Bearing Trees )

1. 10" Hemlock, Now 18", bears S 86° E 31.5 ft., has healed blaze, added TAG.
2. 12" Cedar, Now 19", bears S 65° E 43.6 ft., has healed blaze, added TAG.
3. 30" Fir, Now 33", bears N 18° 45' E 31.0 ft., has horz. healed blaze and Tag.
4. 26" Cedar, Now 32" stump, bears S 28 1/2° W 21.5 ft., tree cut to low, stump 14" tall, has some sign of healed blaze and Tag.
5. 30" Fir, Now a burnt and rotted snag, has no visible blaze or scare, has Tag, this tree bears approx. N 31° W 5.3 ft.

Monument Detail

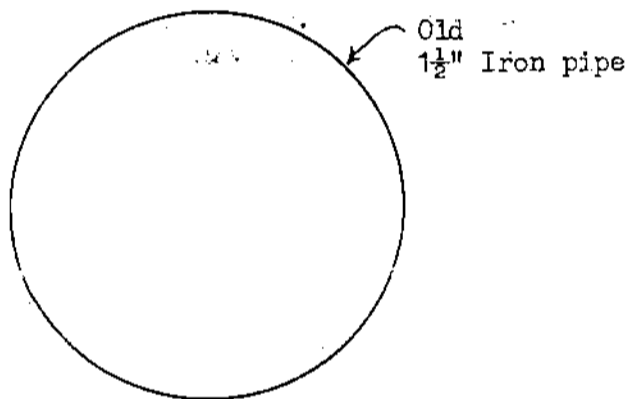

Sketch NO SCALE

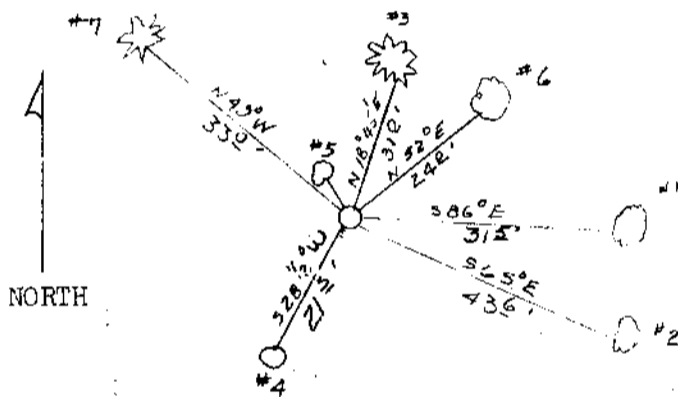

Monument Set: (Procedures and Description) N/A

New Accessories

6. A Cedar, 14" diam., bears N 52° E, 24.0 ft. dist., mkd. ES-2-979 BT.
7. A Fir, 9" diam., bears N 49° W, 33.0 ft. dist., mkd. ES-2-979 BT.

Location & Comments

Corner has no trees within  
limits in the Southwest  
Quadrant.

Compass Declination 19° E  
 Firm/Agency PLS 2391  
Raymond F. Brown  
 Address P.O. Box 539  
Canyonville, OR. 97417  
 Party Chief R. Brown  
 Notes B. Ike  
 Witness J. Haight

Surveyor's Seal

REGISTERED  
PROFESSIONAL  
LAND SURVEYOR

*Handwritten signature: Raymond F. Brown*

OREGON  
JULY 26, 1989  
RAYMOND F. BROWN  
2391

#137 X

C.S. File No. 63/109  
-71 C