

FILED *jh*

APR 2 1990

OREGON CORNER RESTORATION FORM
Section 9 Township 21S Range 4W
County Douglas Date 3-27-90

COUNTY SURVEYOR
DOUGLAS COUNTY, ORE

Corner Designation

S.W. Section Corner

- Condition Report Only
- Not Found
- Renewed
- Unrecorded
- Surveyed In
- Referenced Out

Previous Renewals/Surveys, etc. Set at proportionate distance in a 1972 BLM dependent resurvey. Used in a 1983 survey, map no. M93-60.

Monument(s) & Accessories Found: (Condition and Source)

B.C.I.P. extending 20" above ground and very loose. Record distances to B.T.'s were up to one foot in error. Firmly reset B.C.I.P. at record distance from S.E. and S.W. B.T.'s, extending 6" above ground, from which:

11" fir, bent trunk, bears S12°E, 3.96'. Closed face (1972)

15" dead and leaning fir bears S45°W, 4.63'. Rotting face (1972)


22" fir bears N16°W (rec. = N20°W), 28.39'. Closed face (1972)

18" cedar bears N24°E, 36.81' (rec. = 36.96'). Closed face (1972)

Monument Detail

Found a 1972 BLM 3 1/4" brass cap on a 3" x 30" iron pipe.

Sketch

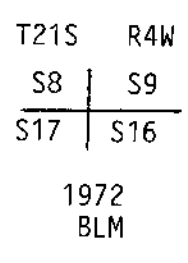

Monument Set (Procedures and Description)

N/A

New Accessories


N/A

Location & Comments

E-W woven fence
1.2' north of corner
Placement of nearby
fence post may have
disturbed monument.

Compass Declination 20°E
Firm/Agency Champion
Intl. Corp.
Address P.O. Box 1328
Roseburg, Or. 97470
Party Chief Ron Geisler
Notes " "
Witness Dean Turner

Surveyor's Seal

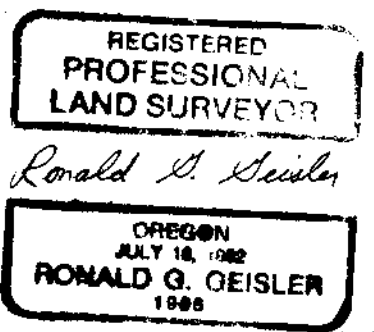

C.S. File No. 63/112-1

#1504