


CERTIFIED RECORD OF LAND CORNER MONUMENTATION

History of original corner establishment

1982 - G. GOODSON, ET.AL., BLM, SET A 5/8" X 4-FT. LONG ALUMINUM ROD W/ AN ALUMINUM CAP IN CONCRETE.

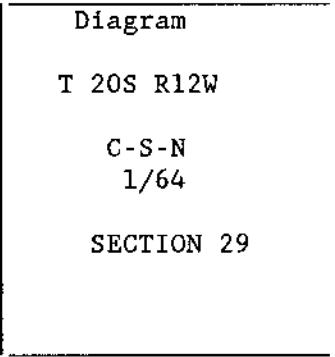

Description of corner evidence found

3" ALUMINUM CAP ON ROD AS NOTED. SET IN CONCRETE WITH STEEL FENCE POST 0.5 FT. NORTH. MARKED:

S 29
C-S-N
1/64
1982


Description of monument and accessories I established to perpetuate the original location of this corner

A 4" SHORE PINEBEARS N 57 3/4 E 35.9 FT. SCRIBED "X" AT CHEST HEIGHT AND "BT" ON A LOWER BLAZE. BRASS WASHER WITH RLS 1050 ATTACHED TO THE LOWER BLAZE.

Bearing basis : CONTROL TRAVERSE ROTATED TO BLM 1982 SURVEY.

Equipment : TOPCON GTS 2 TOTAL STATION

Witnessed : Tom McKee
L.W.HUNNEMULLER

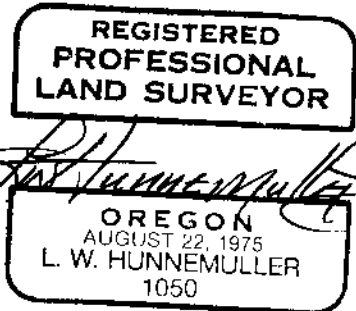

Office of..... Surveyor..... County of..... Douglas.....

State of... Oregon....., I hereby certify that the within instrument was filed in this office for record on the 16th day of November...., 19.90...

.... Fritz Ingram..... by... Virginia A. Sargent.....
(COUNTY OFFICIAL) (DEPUTY)

FORM R6-7100-57 (9/71)

FILED

NOV 16 1990

COUNTY SURVEYOR
DOUGLAS COUNTY, ORE.

C.S. File No. 63/124-2