


CERTIFIED RECORD OF LAND CORNER MONUMENTATION

History of original corner establishment


1982 - G. GOODSON, ET.AL., BLM, SET A STANDARD ALUMINUM CAP MONUMENT,

5" FIR, N 82-1/4 W, 45 LKS., SCRIBED "X BT".
NO OTHER SUITABLE TREES AVAILABLE.
SET A STEEL FENCE POST ALONGSIDE MONUMENT.

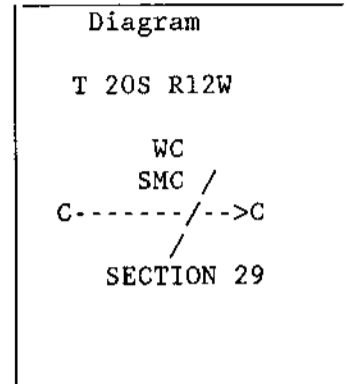

Description of corner evidence found

3" ALUMINUM CAP AND PIPE AS NOTED.
MARKED:

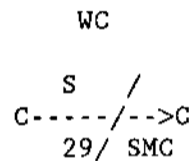

1982

from which :

AN 8" FIR BEARS N 82 1/4 W 29.7 FT.
WITH HEALED BLAZE.

Description of monument and accessories I established to perpetuate the original location of this corner

A 45" SPRUCE BEARS S 15 W 6.8 FT. SCRIBED "X" AT CHEST HEIGHT AND "BT" ON A LOWER BLAZE. BRASS WASHER WITH RLS 1050 ATTACHED TO THE LOWER BLAZE.

Bearing basis : CONTROL TRAVERSE ROTATED TO BLM 1982 SURVEY.

Equipment : TOPCON GTS 2 TOTAL STATION

Witnessed : Tom McKee
L.W.HUNNEMULLER



Office of.....Surveyor.....County of....Douglas.....

State of...Oregon....., I hereby certify that the within instrument was
filed in this office for record on the 16th day of November....., 1990...

.....Fritz Ingram..... by *Virginia C. Laugen*.....
(COUNTY OFFICIAL) (DEPUTY)

FORM R6-7100-57 (9/71)

FILED

SL
NOV 16 1990

COUNTY SURVEYOR
DOUGLAS COUNTY, ORE.

C.S. File No. 63/24-3