


CERTIFIED RECORD OF LAND CORNER MONUMENTATION

History of original corner establishment:

Byars set original corner in 1871
 Bushey found 2 original bts in 1894
 Wenderoth proportioned in new corner in 1947, setting 1 1/2" iron pipe
 Powell found 1 1/2" iron pipe and set 1" iron pipe with brass cap in 1966
 Herzstein found 1" iron pipe in 1981

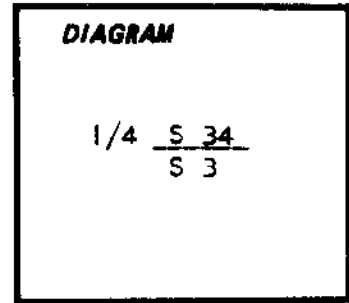

Description of corner evidence found:

1" iron pipe with a 2 1/2" brass cap 10" above ground marked

COUNTY SURVEYORS OFFICE
 T 31 S
 1/4 S 34 R
 S 3 3
 T 32 S W
 1966

Roothole N39 1/2°E, 18.6 ft, 12" D.Fir down and rotted
 Roothole S71 1/2°E, 12.3 ft, 10" D.Fir down and rotted
 20" D.Fir N28°W, 23.8 ft, healed blazes
 10" W.Fir S71 1/2°W, 18.8 ft, (dead) healed blazes

1 1/2" Iron pipe alongside brass capped pipe

Description of monument and accessories I established to perpetuate the original location of this corner:

8" W.Fir S21°W, 13.9 ft, scribed "1/4 S 3 BT", nailed alum. washer marked "Artman RLS 2268" flush to BT face.

FILED
JH
 JUL 26 1990
 COUNTY SURVEYOR
 DOUGLAS COUNTY, ORE.

REGISTERED
 PROFESSIONAL
 LAND SURVEYOR

J. D. Artman

JULY 15, 1987
 JAMES D. ARTMAN
 2234

Office of..... Surveyor..... County of..... Douglas.....
 State of..... Oregon....., I hereby certify that the within instrument was filed in this office
 for record on the 26... day of... December....., 19... 90
 Fritz Ingram..... by *Virginia C. Sawyer*.....
 (COUNTY OFFICIAL) (DEPUTY)

#235 T32-3 ✓
 #258 T31-3 ✓

U.S. File No. 63/124-4
 C