


CERTIFIED RECORD OF LAND CORNER MONUMENTATION

History of original corner establishment: East boundary of T 25 S, R 2 W was originally surveyed by McQuinn in 1883  
 Resurvey of the East boundary was done by Johnson in 1900  
 Resurvey was done by Hosford in 1950

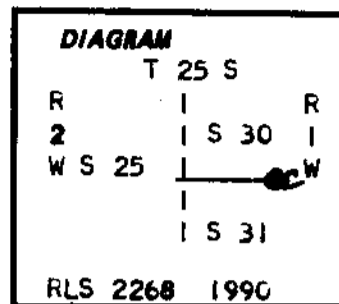

Description of corner evidence found: 1 1/4" iron pipe 5" above ground with stone mound

Description of monument and accessories established to perpetuate the original location of this corner: set 2" galv. iron pipe 30" in length 25" in the ground with a 3" brass cap in a 36" diameter rock mound, marked as shown above.

**Bearing Trees:**

18" Hemlock bears N 43°15' E, 18.8 feet, partial scribing visible  
 28" Cedar bears S 36° E, 32.0 feet, partial scribing visible

NOTE-- 34" Cedar stump (original CC BT) bears N 82° E, 74.0 feet to face, partial scribing visible  
 20" W. Fir snag (original CC BT) bears S 76° 45' E, 68.3 feet to face, partial scribing visible

All bearing trees painted and tagged

REGISTERED  
 PROFESSIONAL  
 LAND SURVEYOR

*J. D. Artman*  
 OREGON  
 (RECEIVED 1987)  
 JAMES D. ARTMAN  
 2268

NOTE-- 34" Cedar stump is a triple trunked tree stump, bearings and distance is the trunk stump most southwesterly (approximately 16" in diameter)

**FILED**

JAN 23 1991  
 COUNTY SURVEYOR  
 DOUGLAS COUNTY, ORE.

Office of...County..Surveyor..... County of...Douglas.....  
 State of...Oregon..... I hereby certify that the within instrument was filed in this office  
 for record on the 23... day of.....January..... 19...91  
 Fritz Ingram ..... by *Virginia A. Saugen*.....  
 (COUNTY OFFICIAL) (DEPUTY)

#160 T25-1 X