

M111-10

FILED

JK

OREGON CORNER RESTORATION FORM

DEC 11 1990

Section 11 Township 21S Range 11W

County Douglas Date 03-02-90

COUNTY SURVEYOR
DOUGLAS COUNTY, ORE.

CORNER DESIGNATION

South 1/4 Corner
Section 11


- Condition Report Only
- Not Found
- Renewed
- Unrecorded
- Surveyed In
- Referenced Out

Previous Renewals/Surveys, etc. 1891 G.L.O. Survey by William Theil and survey M81-43 by Ronald Stuntzner in 1979.

Monument(s) & Accessories Found: (Condition and Source)

- Found 1979 iron pipe and brass cap as set in survey M81-43.
- 9" Cascara, N53W, 14.1' (Bark Scribed), 1979 BT. Record N65W, 14.7'
- 15" Fir, S82E, 12.3' (Scar Vis.), 1979 BT. Record S76E, 12.4'

Monument Detail

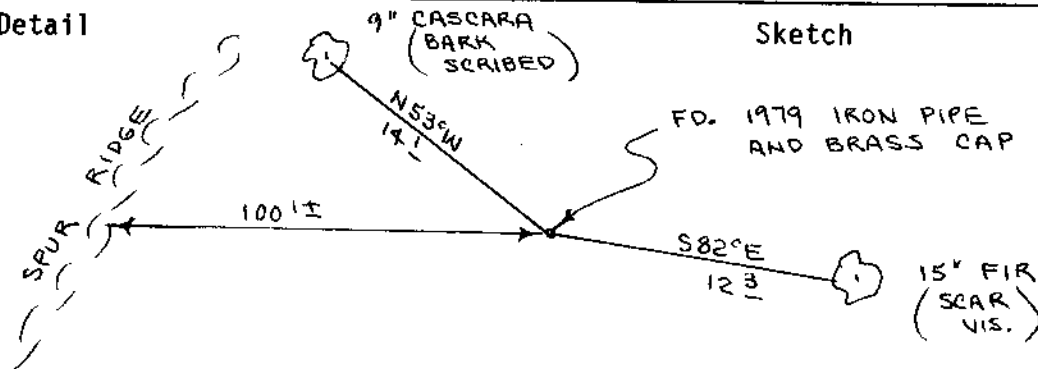

Sketch

Monument Set (Procedures and Description)

New Accessories

Set 60" aluminum post, with land monument survey sign attached to, beside iron pipe. Painted all bearing trees red.

Location & Comments

Corner lies on N.E. slope about 100' East of spur ridge. Ridge bears N.E. and S.W.
 Compass Declination 20 1/2
 Firm/Agency Roberts Surveying Inc.
 Address 29 West 29th St. Eugene, Oregon 97405
 Party Chief Ted Baker
 Notes _____
 Witness Harvey Christensen

Surveyor's Seal

