

1111-10

FILED

DEC 11 1990

OREGON CORNER RESTORATION FORM

Section 11 Township 21S Range 11W  
County Douglas Date 09-25-90

COUNTY SURVEYOR  
DOUGLAS COUNTY, ORE.

CORNER DESIGNATION

C.W. 1/16 Corner  
Section 11


- Condition Report Only
- Not Found
- Renewed
- Unrecorded
- Surveyed In
- Referenced Out

Previous Renewals/Surveys, etc. No previous surveys

Monument(s) & Accessories Found: (Condition and Source)

None

Monument Detail

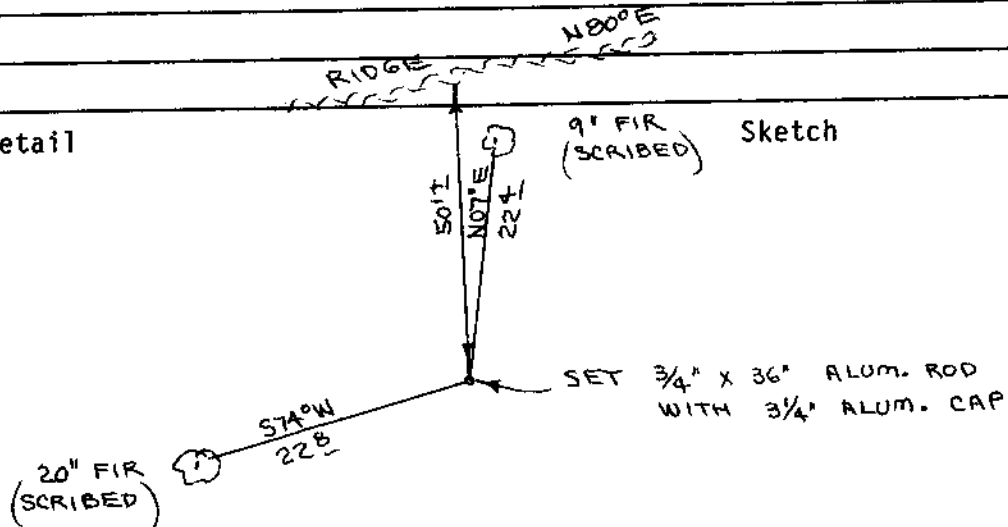

Monument Set (Procedures and Description)

Set 3/4" x 36" Aluminum rod with 3/4" Aluminum cap. Buried purple magnetic marker under 36" aluminum rod. Set 60" aluminum post, with land monument survey sign bolted to, beside aluminum rod. See filed survey for survey procedures.


New Accessories

- 9" Fir, N07E, 22.4' (Scribed/Painted Red)
- 20" Fir, S74W, 22.8' (Scribed/Painted Red)

Location & Comments

Corner lies on S.W. slope about 50' South of ridge. Compass Declination 20 1/2  
Ridge bears S80W and N80E. Firm/Agency Roberts  
Surveying Inc. Address 29 West 29th St.  
Eugene, Oregon 97405  
Party Chief Ted Baker  
Notes  
Witness Harvey Christensen

Surveyor's Seal

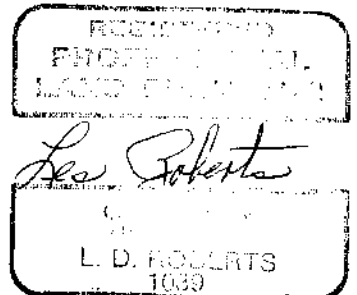

C.S. File No. 63/126-5