

M111-10

FILED

SR

DEC 11 1990

OREGON CORNER RESTORATION FORM

Section 11 Township 21S Range 11W

County Douglas Date 09-25-90

COUNTY SURVEYOR
DOUGLAS COUNTY, ORE.

CORNER DESIGNATION

N.W. 1/16 Corner
Section 11


- Condition Report Only
- Not Found
- Renewed
- Unrecorded
- Surveyed In
- Referenced Out

Previous Renewals/Surveys, etc. No previous surveys.

Monument(s) & Accessories Found: (Condition and Source)

None

Monument Detail

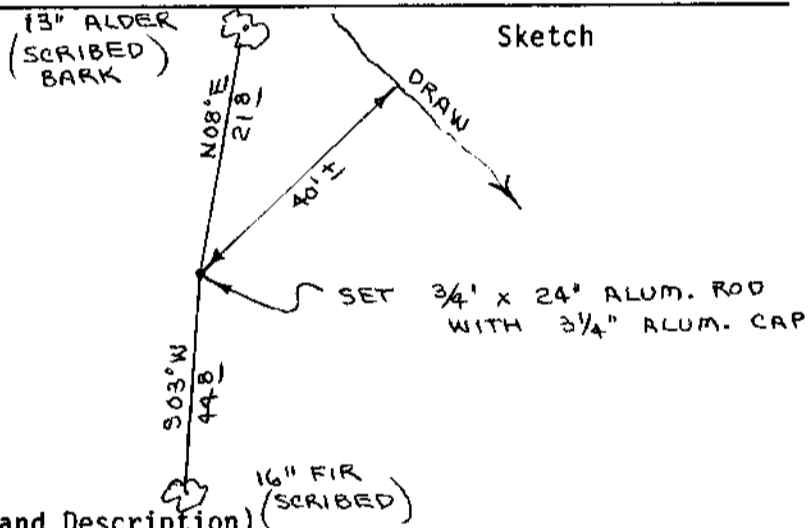

Monument Set (Procedures and Description)

Set 3/4" x 24" Aluminum rod with 3/4" Aluminum cap. Buried purple magnetic marker under 24" Aluminum rod. Set 60" aluminum post, with land monument survey sign bolted to, beside aluminum rod. See files survey for survey procedures.


New Accessories

- 13" Alder, N08E, 21.8' (Bark Scribed/Painted Red)
- 16" Fir, S03W, 44.8' (Scribed/Painted Red)

Location & Comments

Corner lies on East slope about 40' Southwesterly of a small draw. Draw bears N45W and S45E. Compass Declination 20 1/2
Firm/Agency Roberts Surveying Inc.
Address 29 West 29th St. Eugene, Oregon 97405
Party Chief Ted Baker
Notes
Witness Harvey Christensen

Surveyor's Seal

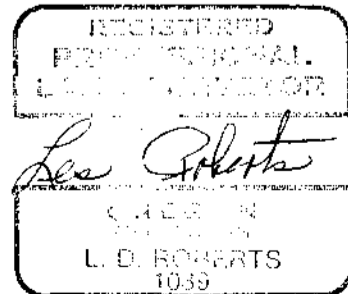

C.S. File No. 63/126-6