

M111-10

FILED

28

OREGON CORNER RESTORATION FORM

DEC 11 1990

Section 11 Township 21S Range 11W

COUNTY SURVEYOR
DOUGLAS COUNTY, ORE.

County Douglas Date 02-28-90

CORNER DESIGNATION

S.W. Corner
Section 11

- Condition Report Only
- Not Found
- Renewed
- Unrecorded
- Surveyed In
- Referenced Out

Previous Renewals/Surveys, etc. 1891 G.L.O. Survey by William Theil, 1960 B.L.M. Survey, Survey M81-43 by Ronald Stuntzner in 1979 and Survey M104-43 by Eugene Wobbe in 1987.

Monument(s) & Accessories Found: (Condition and Source)

Found 1960 B.L.M. Brass Cap set firmly in the ground.


22" Cedar Stump, N69E, 10.6' (Scar Vis.), 1960 BT. Rec. N66E, 10.6'

26" Cedar Stump, S76W, 15.2' (Scar Vis.), 1960 BT. Rec. S77W, 15.8'

30" Cedar Stump, N41W, 18.2' (Scribe Vis.), 1960 BT. Rec. N39W, 19.1'

35" Hemlock Stump, S33E, 7.6' (Scar Vis.), 1960 BT. Rec. S33E, 7.9'

Monument Detail

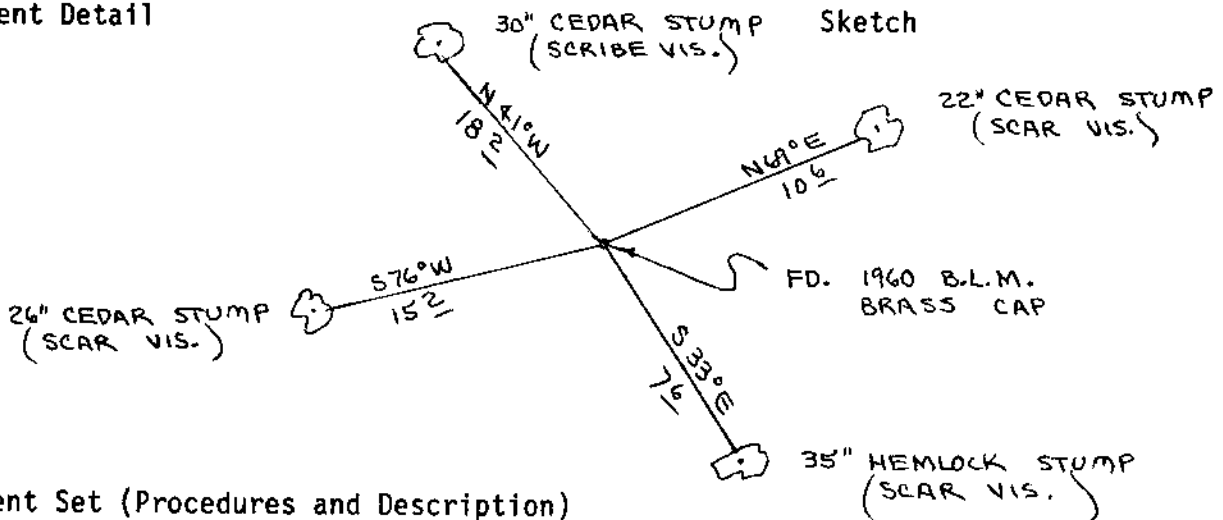

Monument Set (Procedures and Description)

New Accessories

Set 60" aluminum post, with land monument survey sign attached to, beside aluminum rod. Painted all bearing trees red.

Location & Comments

Corner lies on North slope in recently logged unit about 450' North of landing.

Compass Declination 20 1/2

Firm/Agency Roberts Surveying Inc.


Address 29 West 29th St. Eugene, Oregon 97405

Party Chief Les Roberts

Notes Ted Baker

Witness Harvey Christensen

Surveyor's Seal

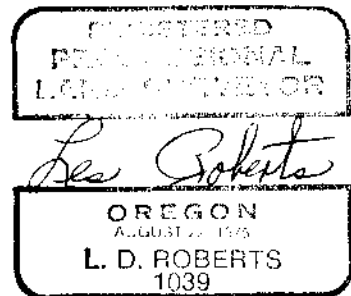

O.S. File No. 63/126-7