

M117-10

FILED

✓

OREGON CORNER RESTORATION FORM

DEC 11 1990

Section 11 Township 21S Range 11W

COUNTY SURVEYOR
DOUGLAS COUNTY, ORE.

County Douglas Date 04-06-90

CORNER DESIGNATION

South 1/16 Corner
Sections 10 and 11


- Condition Report Only
- Not Found
- Renewed
- Unrecorded
- Surveyed In
- Referenced Out

Previous Renewals/Surveys, etc. 1891 G.L.O. Survey by William Theil, Survey M104-43 by Eugene Wobbe in 1987.

Monument(s) & Accessories Found: (Condition and Source)

Found 1987 Aluminum rod with aluminum cap as set in Survey M104-43.
6" Fir, N84W, 8.9' (Scribe Vis.), 1987 BT. Record N83W, 9.0'
13" Fir, N05E, 19.1' (Scribe Vis.), 1987 BT. Record N06E, 19.0'
Found 60" aluminum post, with land monument survey sign attached to,
beside aluminum rod.

Monument Detail

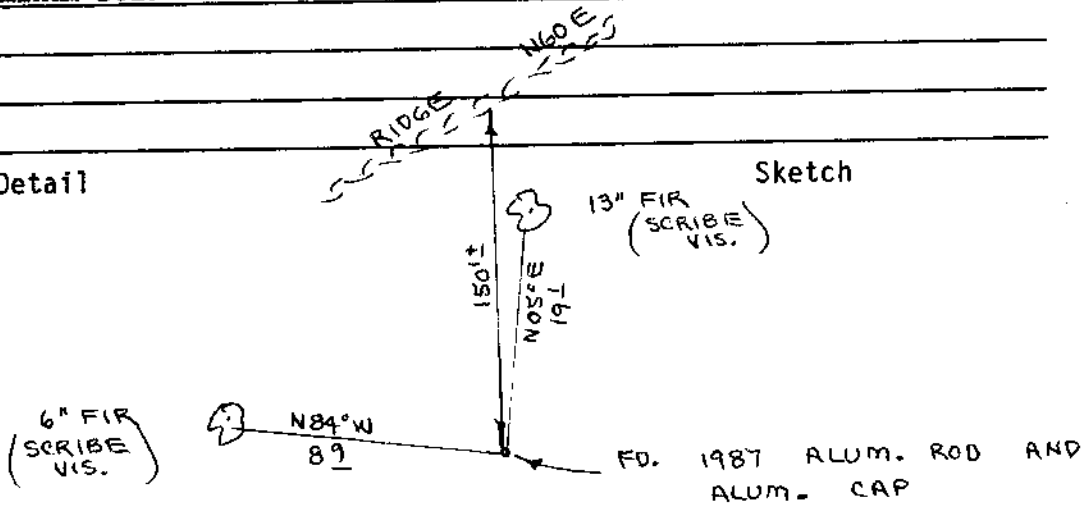


Monument Set (Procedures and Description)

New Accessories

Location & Comments

Corner lies on East slope Compass Declination 20 1/2
about 150' South of ridge. Firm/Agency Roberts
Ridge bears N60E and S60W Surveying Inc.
 _____ Address 29 West 29th St.
 _____ Eugene, Oregon 97405
 _____ Party Chief Ted Baker
 _____ Notes
 _____ Witness Harvey Christensen

Surveyor's Seal

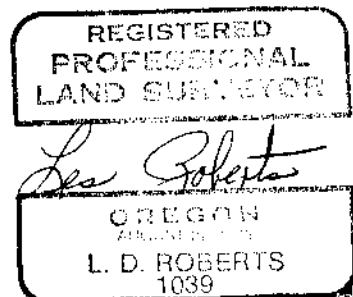

Doc. File No. 63/126-8