

M111-10

FILED

JL

OREGON CORNER RESTORATION FORM

DEC 11 1990

Section 11 Township 21S Range 11W

COUNTY SURVEYOR  
DOUGLAS COUNTY, ORE.

County Douglas Date 09-21-90

CORNER DESIGNATION

North 1/16 Corner  
Sections 10 and 11

- Condition Report Only
- Not Found
- Renewed
- Unrecorded
- Surveyed In
- Referenced Out


Previous Renewals/Surveys, etc. 1891 G.L.O. Survey by William Theil, Survey RM3-48 by Shaner Engineering in 1981 and Survey M104-43 by Eugene Wobbe in 1987.

Monument(s) & Accessories Found: (Condition and Source)

- Found 1987 Aluminum rod with aluminum cap as set in Survey M104-43.
- 14" Maple, N63W, 15.0' (Scribe Vis.), 1987 BT. Record N64W, 15.7'
- 14" Fir, N87E, 15.8' (Scribe Vis.), 1987 BT. Record N86E, 16.0'
- Found 60" aluminum post, with land monument survey sign attached to, beside aluminum rod.

Monument Detail

Sketch

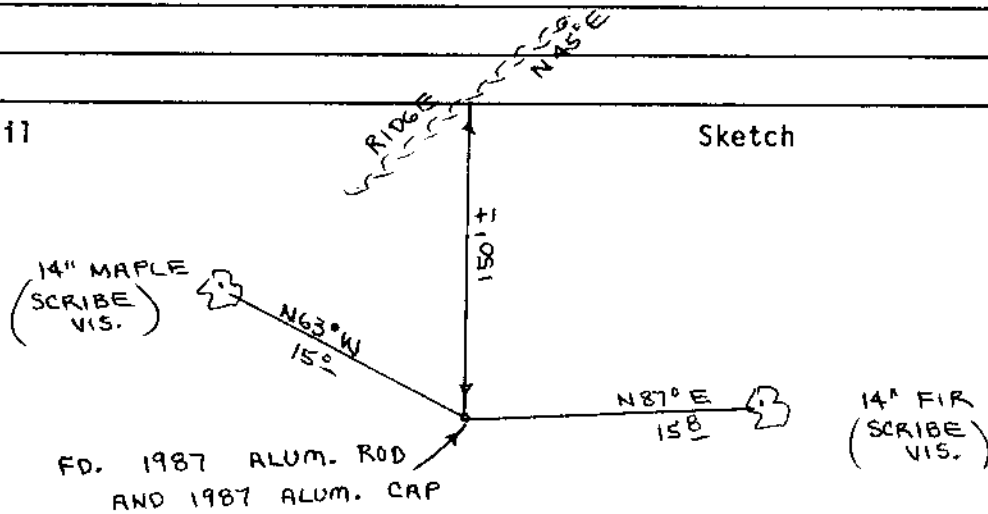

Monument Set (Procedures and Description)

---



---



---



---

New Accessories

---



---



---



---

Location & Comments

Surveyor's Seal

Corner lies on South slope about 150' South of spur ridge. Ridge bears N45E and S45W

Compass Declination 20 1/2

Firm/Agency Roberts Surveying Inc.

Address 29 West 29th St. Eugene, Oregon 97405

Party Chief Ted Baker

Notes \_\_\_\_\_

Witness Richard Rheuban

