

M111-10

FILED

28

DEC 11 1990

OREGON CORNER RESTORATION FORM

Section 11 Township 21S Range 11W

County Douglas Date 03-29-90

COUNTY SURVEYOR
DOUGLAS COUNTY, ORE.

CORNER DESIGNATION

N.W. Corner
Section 11


- Condition Report Only
- Not Found
- Renewed
- Unrecorded
- Surveyed In
- Referenced Out

Previous Renewals/Surveys, etc. 1891 G.L.O. Survey by William Theill, Survey RM3-48 by Shaner Engineering in 1981, Survey M96-5 by Richard Hintz in 1984 and Survey M104-43 by Eugene Wobbe in 1987.

Monument(s) & Accessories Found: (Condition and Source)

Found iron pipe and brass cap as set by Shaner Engineering in Survey RM3-48.
12" Fir, S63E, 45.5' (Scar Vis.) , 1981 BT. Record S63E, 46.0'
14" Fir, N24E, 11.4' (Scar Vis.) , 1981 BT. Record N24E, 11.5'
22" Fir, S63W, 66.3' (Scribe Vis.) , 1981 BT. Record S63W, 66.6'

Monument Detail

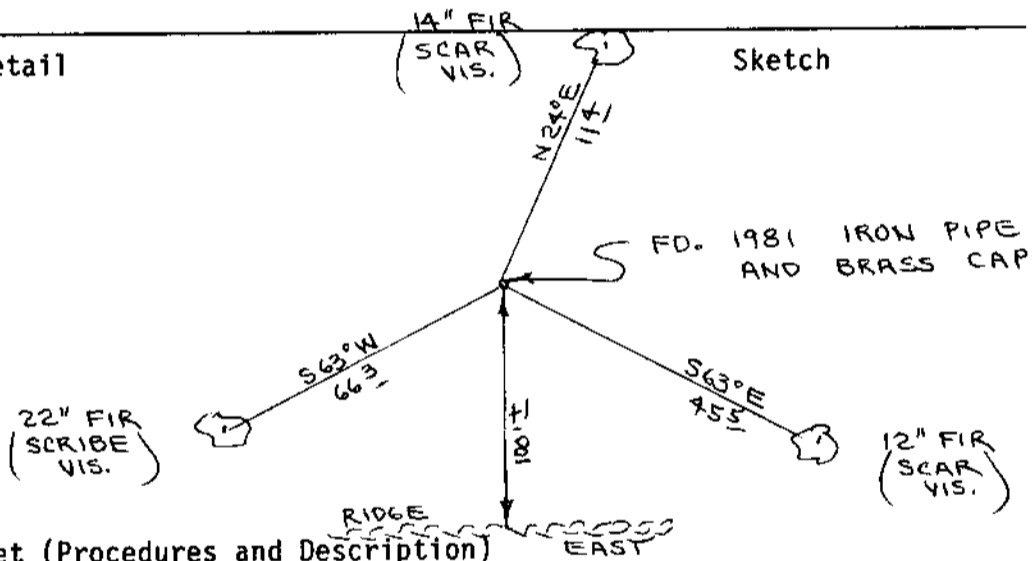

Monument Set (Procedures and Description)

Set 60" Aluminum post, with land monument survey sign bolted to, beside iron pipe. Painted all bearing trees red.

New Accessories

Location & Comments

Corner falls on North slope Compass Declination 20 1/2

about 100' North of ridge. Firm/Agency Roberts

Ridge bears East-West Surveying Inc.

Address 29 West 29th Street


Eugene, Oregon 97405

Party Chief Les Roberts

Notes _____

Witness Harvey Christensen

Surveyor's Seal

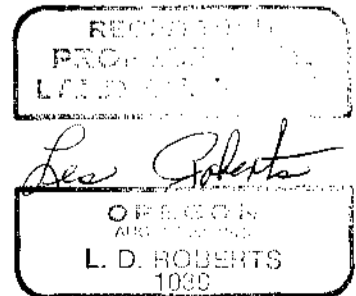

C.S. File No. 63/126-11