

M 111-10

FILED

JK

DEC 11 1990

OREGON CORNER RESTORATION FORM

Section 11 Township 21S Range 11W

County Douglas Date 03-29-90

COUNTY SURVEYOR  
DOUGLAS COUNTY, ORE.

CORNER DESIGNATION

West 1/16 Corner  
Section 2 and 11


- Condition Report Only
- Not Found
- Renewed
- Unrecorded
- Surveyed In
- Referenced Out

Previous Renewals/Surveys, etc. 1891 G.L.O. Survey by William Theil, Survey RM3-48 by Shaner Engineering in 1981 and Survey M96-5 by Richard Hintz in 1984.

Monument(s) & Accessories Found: (Condition and Source)

Found 1 1/2" iron pipe with brass cap as set by Richard Hintz in Survey M96-5  
22" Cedar, N31E, 14.0' (Scribe Vis.), 1984 BT, Record N30 1/2 E, 13.9'  
22" Fir, S86W, 28.4' (Scar Vis.), 1984 BT, Record S86 1/2 W, 28.0'

Monument Detail

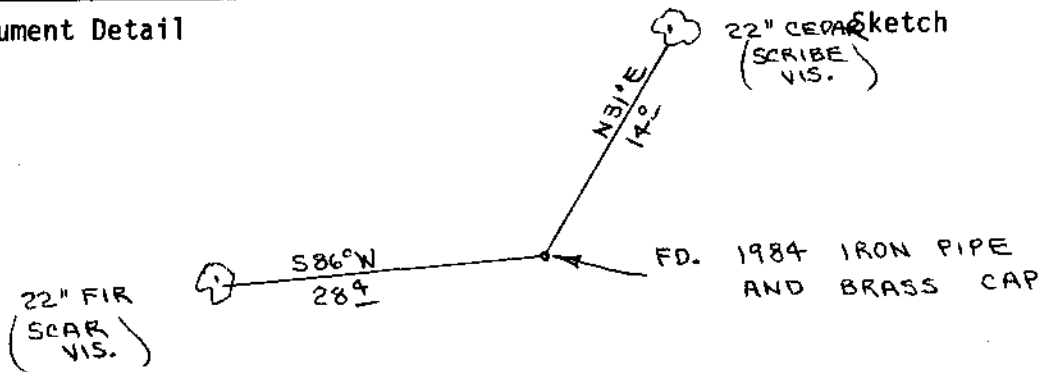

Monument Set (Procedures and Description)


New Accessories

Painted both bearing trees red.

Location & Comments

Corner lies on steep North slope about 400' South of Smith River  
Compass Declination 20 1/2  
Firm/Agency Roberts Surveying Inc.  
Address 29 West 29th St. Eugene, Oregon 97405  
Party Chief Les Roberts  
Notes  
Witness Harvey Christensen

Surveyor's Seal

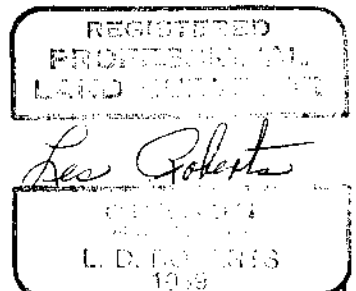

C.S. File No. 63/126-12