

M111-10

FILED

DEC 11 1990

OREGON CORNER RESTORATION FORM

Section 11 Township 21S Range 11W

County Douglas Date 03-29-90

COUNTY SURVEYOR
DOUGLAS COUNTY, ORE.

CORNER DESIGNATION

North $\frac{1}{4}$ Corner
Section 11

- Condition Report Only
- Not Found
- Renewed
- Unrecorded
- Surveyed In
- Referenced Out

Previous Renewals/Surveys, etc. 1891 G.L.O. Survey by William Thiel, Survey RM3-48 by Shaner Engineering in 1981 and Survey M96-5 by Richard Hintz in 1984.

Monument(s) & Accessories Found: (Condition and Source)


Found 5/8" iron pin with 1 1/2" aluminum cap set by Shaner Engineering in Survey RM3-48.

12" Downed Fir, S62W, 58.5' (Scribe Vis.), 1981 BT. Record S62W, 58.5'

16" Fir, N37E, 79.5' (Scar Vis.), 1981 BT. Record N37E, 79.2'

Monument Detail

Sketch

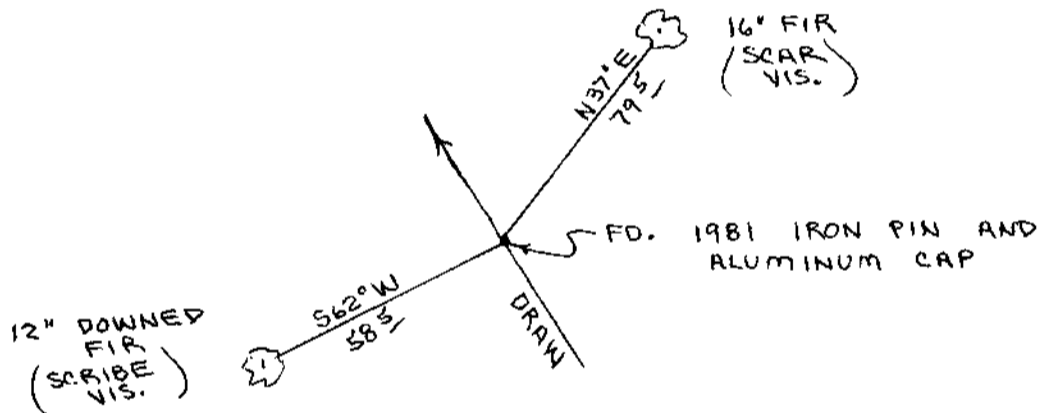

Monument Set (Procedures and Description)

New Accessories

Set 60" Aluminum Post, with land monument survey sign bolted to, beside iron rod. Painted all bearing trees red.

Location & Comments

Corner is in the bottom of a steep draw. Draw runs N.W. and S.E.

Firm/Agency Roberts Surveying Inc.

Address 29 West 29th St. Eugene, Oregon 97405

Party Chief Les Roberts

Notes

Witness Harvey Christensen

Surveyor's Seal

