

M111-10

FILED

28

OREGON CORNER RESTORATION FORM

DEC 11 1990

Section 11 Township 21S Range 11W

County Douglas Date 09-25-90

COUNTY SURVEYOR
DOUGLAS COUNTY, ORE.

CORNER DESIGNATION

Center 1/4 Corner
Section 11


- Condition Report Only
- Not Found
- Renewed
- Unrecorded
- Surveyed In
- Referenced Out

Previous Renewals/Surveys, etc. No previous surveys.

Monument(s) & Accessories Found: (Condition and Source)

None

Monument Detail

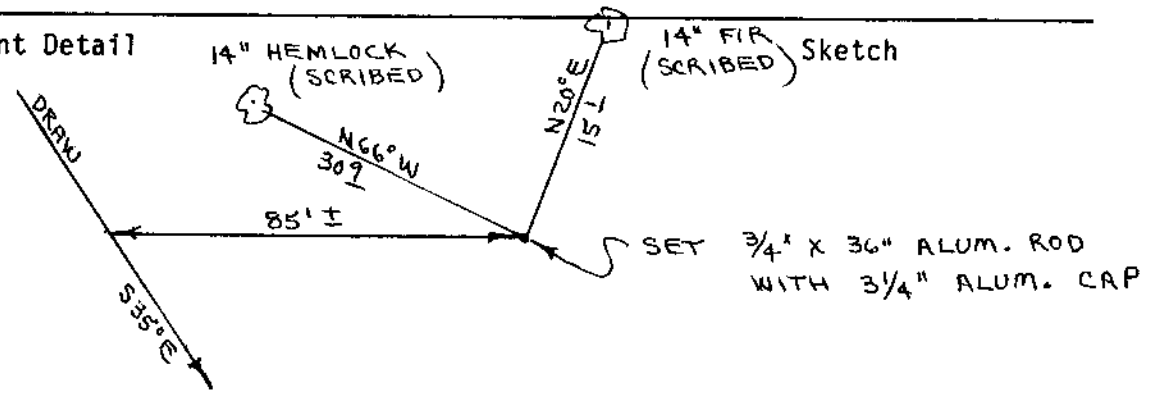

Monument Set (Procedures and Description)

Set 3/4" x 36" Aluminum rod with 3/4" Aluminum cap. Buried purple magnetic marker under 36" aluminum rod. Set 60" aluminum post, with land monument survey sign bolted to, beside aluminum rod. See filed survey for survey procedures.

New Accessories


- 14" Hemlock, N66W, 30.9' (Scribed/Painted Red)
- 14" Fir, N20E, 15.1' (Scribed/Painted Red)

Location & Comments

Corner lies on S.W. slope about 85' East of small draw. Draw bears S35E and N35W.

Compass Declination 20 1/2
 Firm/Agency Roberts Surveying Inc.
 Address Roberts 29 West 29th St., Eugene, Ore. 97405
 Party Chief Ted Baker
 Notes _____
 Witness Harvey Christensen

Surveyor's Seal

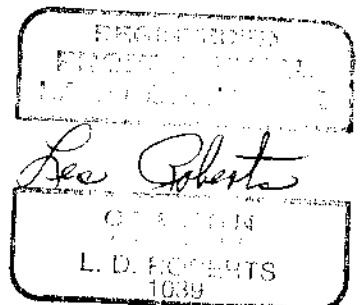

C.S. File No. 63/126-14