

M 111-9

FILED
JK

DEC 11 1990

OREGON CORNER RESTORATION FORM

Section 30 Township 21S Range 11W
County Douglas Date 10-10-90

COUNTY SURVEYOR
DOUGLAS COUNTY, ORE.

CORNER DESIGNATION

C.N. 1/16 Corner
Section 30

- Condition Report Only
- Not Found
- Renewed
- Unrecorded
- Surveyed In
- Referenced Out


Previous Renewals/Surveys, etc. Survey M70-10 by Richard Hintz in 1978,
Survey M70-74 by Richard Hintz in 1979 and Survey M92-12 by Richard Hintz
in May of 1982.

Monument(s) & Accessories Found: (Condition and Source)

None

Monument Detail

Sketch

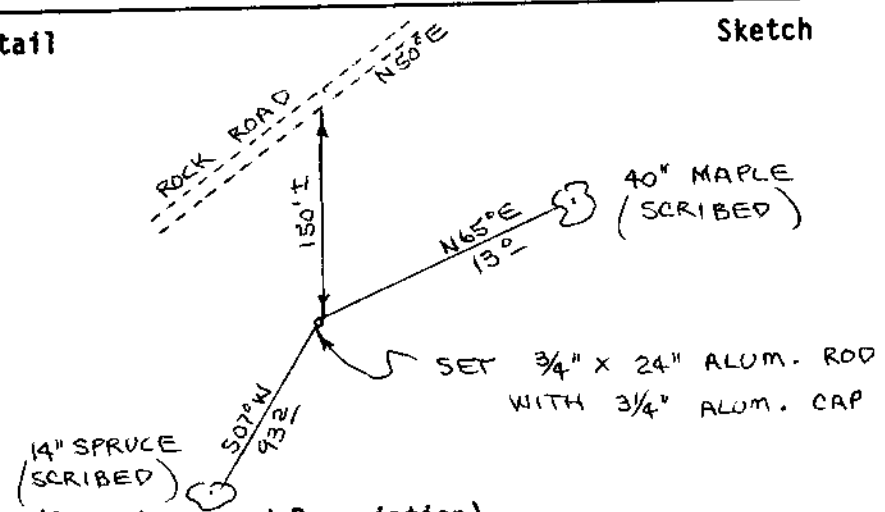

Monument Set (Procedures and Description)

Set 3/4" x 24" Aluminum rod with 3/4" Aluminum cap. Buried purple magnetic
marker under 24" aluminum rod. Set 60" aluminum post, with land monument
survey sign bolted to, beside aluminum rod. See filed survey for survey
procedures.

New Accessories

- 14" Spruce, S07W, 93.2' (Scribed/Painted Red)
- 40" Maple, N65E, 13.0' (Scribed/Painted Red)

Location & Comments

Corner lies on flat ridge about 150' South of road. Compass Declination 20 1/2
Firm/Agency Roberts
Surveying Inc.
Address 29 West 29th St.
Eugene, Oregon 97405
Party Chief Ted Baker
Notes
Witness Harvey Christensen

Surveyor's Seal

REGISTERED
PROFESSIONAL
LAND SURVEYOR

L. D. Roberts

OREGON
AUGUST 22, 1975
L. D. ROBERTS
1039