

M 111-9

FILED

DEC 11 1990

OREGON CORNER RESTORATION FORM

Section 30 Township 21S Range 11W

County Douglas Date 06-27-90

COUNTY SURVEYOR
DOUGLAS COUNTY, ORE.

CORNER DESIGNATION

N.W. Corner
Section 30

- Condition Report Only
- Not Found
- Renewed
- Unrecorded
- Surveyed In
- Referenced Out

Previous Renewals/Surveys, etc. 1891 G.L.O. Survey by William Thiel, Survey M62-1 by Hintz in 1976, Survey M70-10 by Hintz in 1978, Survey M70-74 by Hintz in 1979, Survey M88-52 by Hintz in 1981 and Survey M92-12 by Hintz Monument(s) & Accessories Found: (Condition and Source) in May of 1982

Found 5/8" iron pin as set by Richard Hintz in survey M62-1.


16" Cedar Snag, N59W, 58.0' (No Marks), 1976 BT. Record N58W, 58.1'

18" Hemlock Stump, S05E, 23.0' (No Marks), 1976 BT. Record S05E, 22.7'

24" Hemlock Stump, S81E, 23.9' (No Marks), 1976 BT. Record S82E, 23.6'

32" Cedar Stump, N70E, 36.5' (No Marks), 1976 BT. Record N71E, 36.7'

T21-11
Ren #54
T21-12
#56

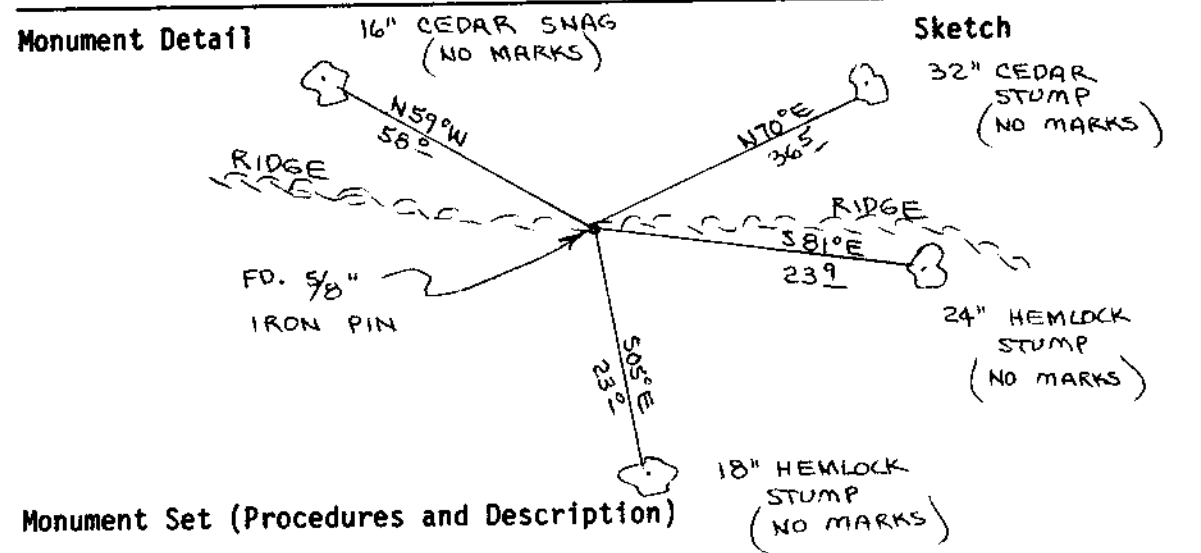

Monument Set (Procedures and Description)

New Accessories
Set 60" Aluminum Post, with land monument survey sign bolted to, beside iron pin. Painted all bearing trees red.

Location & Comments
 Corner lies on top of a narrow ridge. Ridge bears N.W. and S.E.
 Compass Declination 20 1/2
 Firm/Agency Roberts Surveying Inc.
 Address 29 West 29th St. Eugene, Oregon 97405
 Party Chief Les Roberts
 Notes Ted Baker
 Witness _____

Surveyor's Seal



C.S. File No. 63/126-19