

M111-9

FILED

DEC 11 1990

OREGON CORNER RESTORATION FORM

Section 30 Township 21S Range 11W

County Douglas Date 06-26-90

COUNTY SURVEYOR
DOUGLAS COUNTY, ORE.

CORNER DESIGNATION

East 1/4 Corner
Section 30

- Condition Report Only
- Not Found
- Renewed
- Unrecorded
- Surveyed In
- Referenced Out

Previous Renewals/Surveys, etc. 1891 G.L.O. Survey by William Thiel, Survey M70-10 by Richard Hintz in 1978, Survey M70-74 by Richard Hintz in 1979 and Survey M92-12 by Richard Hintz in 1982.

Monument(s) & Accessories Found: (Condition and Source)

Found 1 1/4" iron pipe with brass cap as set by Richard Hintz in survey M92-12. Brass cap stamped "P.L.S. 497" and dated 1978.


24" Maple, S07E, 68.5' (Scribe Vis.), 1982 BT. Record S07 1/2 E, 68.1'

60" Fir Stump, N70E, 34.0' (Scribe Vis.), 1982 BT. Record N70 1/2 E, 34.0'

Revised

Monument Detail

Sketch

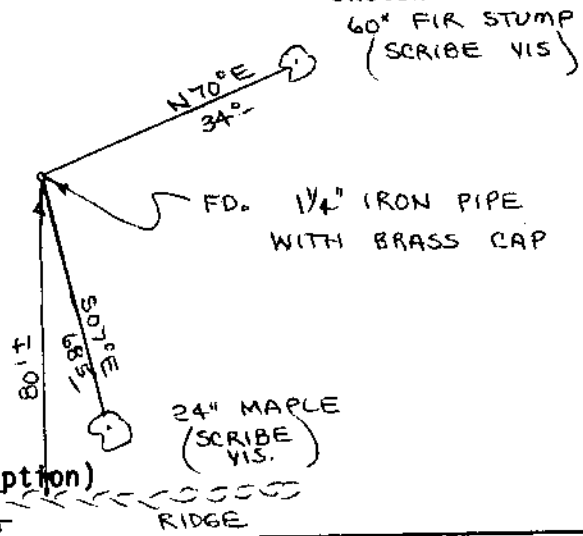

Monument Set (Procedures and Description)

New Accessories

Set 60" Aluminum Post, with land monument survey sign bolted to, beside iron pipe. Painted all bearing trees red.

Location & Comments

Corner lies on West slope about 80' North of spur ridge. Ridge bears East and West. Compass Declination 20 1/2
Firm/Agency Roberts
Surveying Inc.
Address 29 West 29th St. Eugene, Oregon 97405
Party Chief Les Roberts
Notes Ted Baker
Witness

Surveyor's Seal

REGISTERED
PROFESSIONAL
LAND SURVEYOR

Les Roberts

OREGON
AUGUST 23 1975
L. D. ROBERTS
1039