

M 111-9

FILED

DEC 11 1990

OREGON CORNER RESTORATION FORM

Section 30 Township 21S Range 11W

County Douglas Date 06-26-90

COUNTY SURVEYOR  
DOUGLAS COUNTY, ORE.

CORNER DESIGNATION

South 1/4 Corner  
Section 30

- Condition Report Only
- Not Found
- Renewed
- Unrecorded
- Surveyed In
- Referenced Out

Previous Renewals/Surveys, etc. 1891 G.L.O. Survey by William Thiel, Survey M70-10 by Richard Hintz in 1978, Survey M70-74 by Richard Hintz in 1979 and Survey M92-12 by Richard Hintz in 1982.


Monument(s) & Accessories Found: (Condition and Source)

Found iron pipe and brass cap as set by Richard Hintz in survey M92-12.  
11" Alder, S62E, 122.4' (Bark Scribed), 1982 BT. Record S61 3/4E, 122.1'  
24" Spruce, S10E, 75.2' (Scribe Vis.), 1982 BT. Record S10 1/2 E, 75.2'  
Found metal fence post beside corner.

*Rec'd 1/5/1*

Monument Detail

Sketch

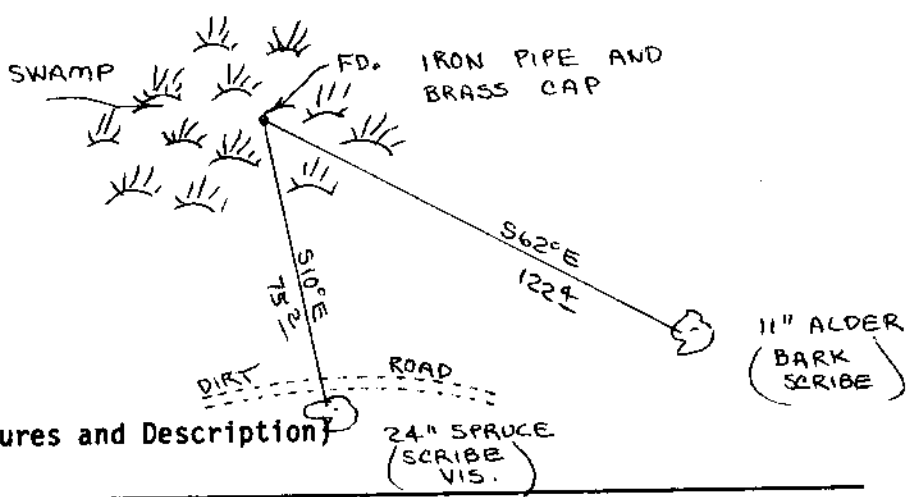

Monument Set (Procedures and Description)

New Accessories

Painted all bearing treed red.

Location & Comments

Corner lies in wet, swampy ground about 75' North of old dirt road Compass Declination 20 1/2  
 Firm/Agency Roberts Surveying Inc.  
 Address 29 West 29th St. Eugene, Oregon 97405  
 Party Chief Les Roberts  
 Notes Ted Baker  
 Witness \_\_\_\_\_

Surveyor's Seal

REGISTERED PROFESSIONAL LAND SURVEYOR

*Les Roberts*

OREGON  
AUGUST 22 1858  
L. D. ROBERTS  
1039