

M111-9

FILED

DEC 11 1990

OREGON CORNER RESTORATION FORM

Section 30 Township 21S Range 11W

County Douglas Date 10-10-90

COUNTY SURVEYOR
DOUGLAS COUNTY, ORE.

CORNER DESIGNATION

Center 1/4 Corner
Section 30


- Condition Report Only
- Not Found
- Renewed
- Unrecorded
- Surveyed In
- Referenced Out

Previous Renewals/Surveys, etc. Survey M70-10 by Richard Hintz in 1978,
Survey M70-74 by Richard Hintz in 1979 and Survey M92-12 by Richard Hintz
in May of 1982.

Monument(s) & Accessories Found: (Condition and Source)

None

Monument Detail

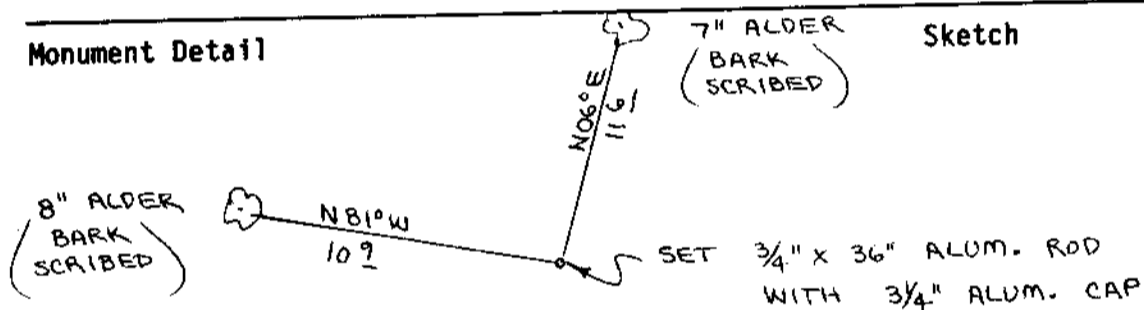

Monument Set (Procedures and Description)

Set 3/4" Aluminum rod with 3/4" Aluminum cap. Buried purple magnetic
marker under 24" Aluminum rod. Set 60" aluminum post, with land monument
survey sign bolted to, beside aluminum rod. See filed survey for survey
procedures.

New Accessories

7" Alder, N06E, 11.6' (Bark Scribed/Painted Red)

8" Alder, N81W, 10.9' (Bark Scribed/Painted Red)

Location & Comments

Corner lies on Southwest Compass Declination 20 1/2
edge of a broad, flat ridge. Firm/Agency Roberts

Surveying Inc.

Address 29 West 29th St.


Eugene, Oregon 97405

Party Chief Ted Baker

Notes

Witness Harvey Christensen

Surveyor's Seal

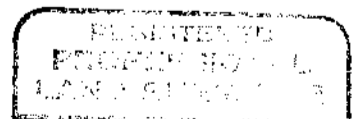

L. D. Roberts
L. D. ROBERTS
1033