

M 111-9

FILED

DEC 11 1990

OREGON CORNER RESTORATION FORM

Section 30 Township 21S Range 11W

County Douglas Date 10-10-90

COUNTY SURVEYOR
DOUGLAS COUNTY, ORE.

CORNER DESIGNATION

North 1/4 Corner
Section 30

- Condition Report Only
- Not Found
- Renewed
- Unrecorded
- Surveyed In
- Referenced Out


Previous Renewals/Surveys, etc. 1891 G.L.O. Survey by William Thiel. Survey M62-1 by Hintz in 1976, Survey M70-10 by Hintz in 1978, Survey M70-74 by Hintz in 1979, Survey M88-52 by Hintz in 1981 and Survey M92-12 by Hintz in May of 1982

Monument(s) & Accessories Found: (Condition and Source)
None

232

Monument Detail

Sketch

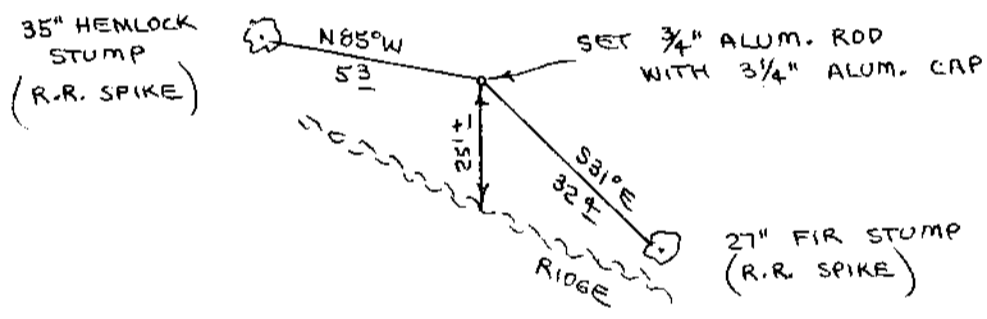

Monument Set (Procedures and Description)

Set 3/4" x 36" Aluminum rod with 3/4" aluminum cap by single proportionate measure. Buried purple magnetic marker under 36" aluminum rod. Set 60° aluminum post, with land monument survey sign bolted to, beside aluminum rod. See filed survey for survey procedures.

New Accessories

27" Fir Stump, S31E, 32.4' (R.R. Spike/Painted Red)
35" Hemlock Stump, N85W, 5.3' (R.R. Spike/Painted Red)
Distances are to R.R. Spikes driven in to face of stumps.

Location & Comments

Corner lies on steep North Compass Declination 20 1/2
slope about 25' North of Firm/Agency Roberts
Ridge. Ridge bears N.W. and Surveying Inc.
S.E. Address 29 West 29th St.
Eugene, Oregon 97405
Party Chief Ted Baker
Notes
Witness Harvey Christensen

Surveyor's Seal

REGISTERED
PROFESSIONAL
LAND SURVEYOR

Les Roberts

OREGON
AUGUST 22, 1973
L. D. ROBERTS
1039

#2324

O.S. File No. 63/126-23