

M 111-9

FILED

th

DEC 11 1990

OREGON CORNER RESTORATION FORM

Section 30 Township 21S Range 11W

COUNTY SURVEYOR  
DOUGLAS COUNTY, ORE.

County Douglas Date 06-27-90

CORNER DESIGNATION

N.E. Corner  
Section 30

- Condition Report Only
- Not Found
- Renewed
- Unrecorded
- Surveyed In
- Referenced Out

Previous Renewals/Surveys, etc. 1891 G.L.O. Survey by William Thiel, Survey M62-1 by Hintz in 1976, Survey M70-10 by Hintz in 1978, Survey M70-74 by Hintz in 1979, Survey M88-52 by Hintz in 1981 and Survey M92-12 by Hintz  
Monument(s) & Accessories Found: (Condition and Source) in May of 1982

Found 1 1/4" iron pipe as set in Renewal #10.


14" Cedar Stub, North, 4.0' (Scribe Vis.), 1975 BT. Rec. N01E, 3.8'

22" Hemlock, S15W, 26.0' (Scribe Vis.), 1975 BT. Rec. S14W, 26.3'

34" Hemlock, S81W, 30.3' (Scribe Vis.), 1975 BT. Rec. S81 1/2 W, 30.3'

46" Downed Hemlock, N22W, 31.3' (Scribe Vis.), 1975 BT. Rec. N22 1/4 W, 31.3'

Monument Detail

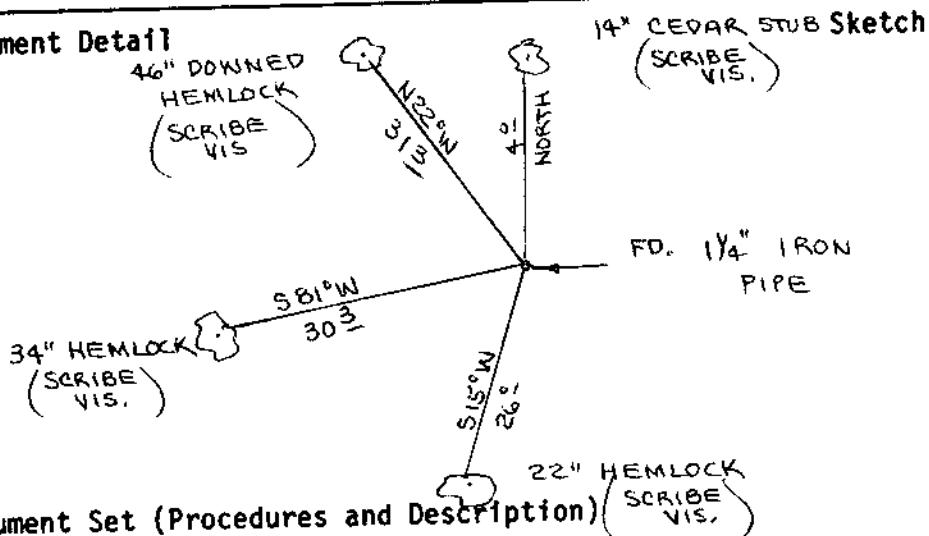

Monument Set (Procedures and Description)

\_\_\_\_\_  
\_\_\_\_\_  
\_\_\_\_\_

New Accessories

Set 60" Aluminum Post, with land monument survey sign bolted to, beside iron pipe.

Location & Comments

Corner lies on a S.E. slope about 450' South of road  
Compass Declination 20 1/2  
Firm/Agency Roberts Surveying Inc.  
Address 29 West 29th St. Eugene, Oregon 97405  
Party Chief Les Roberts  
Notes Ted Baker  
Witness

Surveyor's Seal

REGISTERED  
PROFESSIONAL  
LAND SURVEYOR

*Les Roberts*

OREGON  
AUGUST 22 1975  
L. D. ROBERTS  
1039