

M 111-9

FILED

DEC 11 1990

OREGON CORNER RESTORATION FORM

Section 30 Township 21S Range 11W

County Douglas Date 06-26-90

COUNTY SURVEYOR  
DOUGLAS COUNTY, ORE.

CORNER DESIGNATION


West 1/4 Corner  
Section 30.

- Condition Report Only
- Not Found
- Renewed
- Unrecorded
- Surveyed In
- Referenced Out

Previous Renewals/Surveys, etc. 1891 G.L.O. Survey by William Thiel, Survey M62-1 by Richard Hintz in 1976, Survey M70-10 by Richard Hintz in 1978, Survey M70-74 by Richard Hintz in 1979 and Survey M92-12 by Richard Hintz in  
 Monument(s) & Accessories Found: (Condition and Source) May of 1982

- Found 5/8" iron pin as set by Richard Hintz in survey M62-1.
- 16" Spruce Stump, S10E, 31.1' (No Marks), 1976 BT, Record S09E, 31.5'
- 65" Fir Stump, N45W, 4.5' (Bark Scribe), 1976 BT, Record N45W, 1.8'

Monument Detail

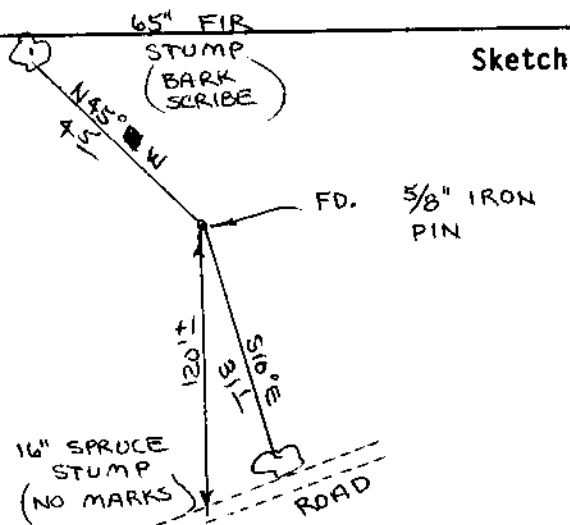

Monument Set (Procedures and Description)

New Accessories

Set 60" Aluminum Post, with land monument survey sign bolted to, beside iron pin. Painted all bearing trees red.

Location & Comments

Corner lies on North slope about 120' North of road. Compass Declination 20 1/2  
Corner lies in recently logged unit. Firm/Agency Roberts Surveying Inc.  
Address 29 West 29th St, Eugene, Oregon 97405  
Party Chief Les Roberts  
Notes Ted Baker  
Witness

Surveyor's Seal

REGISTERED  
PROFESSIONAL  
LAND SURVEYOR

*Les Roberts*

OREGON  
AUGUST 29, 1975  
L. D. ROBERTS  
1039