

T

OREGON CORNER RESTORATION FORM

FILED

Section 36<sup>31</sup> Township 22S Range 6W

DEC 12 1990

County DOUGLAS Date 10/90

Corner Designation

T22S	
R7W	R6W
S36	S31
S1	

COUNTY SURVEYOR

DOUGLAS COUNTY, ORE.  
 Condition Report Only  
 Not Found  
 Renewed  
 Unrecorded  
 Surveyed In  
 Referenced Out

Previous Renewals/Surveys, etc.

Monument(s) & Accessories Found: (Condition and Source)

1956 BLM

CORNER IS A GLO BRASS CAP 1<sup>2</sup>/<sub>2</sub>" ABOVE GROUND IN GOOD CONDITION  
 18" D.F. BEARS N38<sup>1</sup>/<sub>2</sub>° E 60.0° FT WELL HEADED FACE, WE TAG  
 42" D.F. BEARS N39° W 49.5° FT WELL HEADED FACE, AND B.T. TAG  
 NO RECORD - 38" D.F. STUMP (COVERED WITH TIN) BEARS N16° W 23.5° FT SCRIBING VARIABLE,  
 AND B.T. TAG.

HAWKS T-IRON BEARS S38<sup>1</sup>/<sub>2</sub>° E 14° FT.


Monument Detail

Sketch

REN # 27  
T22-6  
#24 T22-7  
#9 T23-6  
(Not typed in)  
T23-7



S3° 43' E  
 PER KEN HOFFINE  
 12-6-93

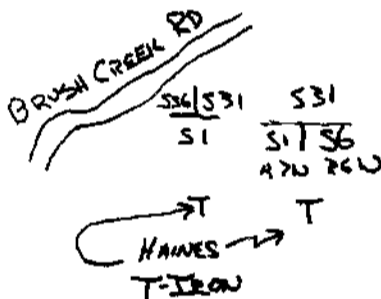

Monument Set (Procedures and Description)

New Accessories


PAINTED FACES AND WROTE B.T. ON TREE TRUNKS OF B.T.'S WITH FLUOR ORANGE PAINT.

Location & Comments

CORNER SITS ON 40%  
 WEST SLOPE APPROX  
 100 FEET EAST OF  
 BRUSH CREEK RD.

Compass Declination 19<sup>1</sup>/<sub>2</sub>  
 Firm/Agency LOWE ROCK  
TIMBER COMPANY  
 Address P.O. BOX 1127  
ROSEBURG  
 Party Chief KEN HOFFINE  
 Notes  
 Witness GARY ANGIOLET

Surveyor's Seal

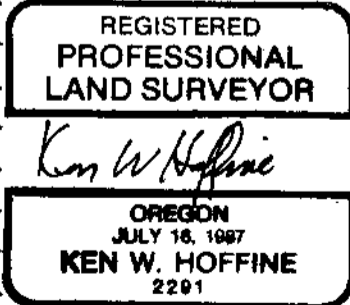

# 195 T22-7 X  
 # 155 T.22-6 X  
 # 86 T23-6 X

C.S. File No. 63/127-3