

FILED

DEC 12 1990

OREGON CORNER RESTORATION FORM

Section 31 Township 22S Range 6W

COUNTY SURVEYOR
DOUGLAS COUNTY, ORE.

County DOUGLAS Date 10/90

Corner Designation

A P
T22S R6W
S31

- Condition Report Only
- Not Found
- Renewed
- Unrecorded
- Surveyed In
- Referenced Out

Previous Renewals/Surveys, etc.



Monument(s) & Accessories Found: (Condition and Source)

1956 31 M
1956
ORIG BT
1956

- ✓ CORNER IS A GLO BRASS CAP WITH 1"x1" SQUARE IRON ROD, AND 4"x4" SCRIBED CEMR POST ALONG SIDE CORNER IS IN GOOD CONDITION
- ✓ 9" DOGWOOD BEARS S58°E 25.3 FT BARK SCRIBED, PUT UP TAG
- 44" DF BEARS S56°E 40 FT (RECORD 382) WELL HEALED FACE AND TWO B.T. TAGS
- ✓ 12" CHINKAPIN (DEAD AND BROKEN DOWN BEARS N81°W 29.3 FT WITH B.T. TAG

Monument Detail

Sketch

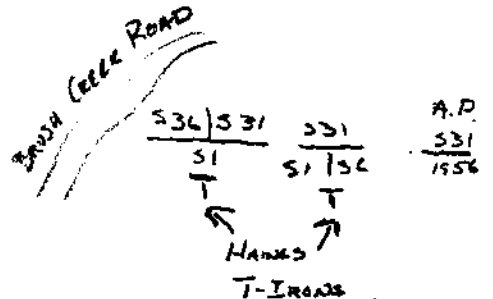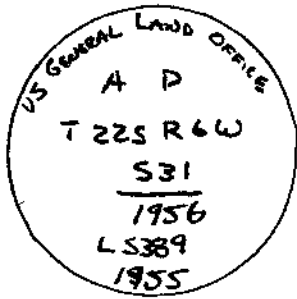

Monument Set (Procedures and Description)

New Accessories

PAINTED FACES AND WROTE B.T. ON TREE TRUNKS OF B.T.'S WITH FLOUR ORANGE PAINT

Location & Comments

CORNER SITS ON FLAT
336.5 FT EAST OF THE
NWSC OF SECTION 6

Compass Declination 19 1/2°
 Firm/Agency LOWE ROCK
TIMBER COMPANY
 Address P.O. BOX 1127
ROSEBURG
 Party Chief KEN HOFFINE
 Notes
 Witness GARY ANGIOLET

Surveyor's Seal

