

FILED

T

OREGON CORNER RESTORATION FORM

DEC 12 1990

Section 32 Township 22S Range 6W

County DOUGLAS Date 10/90

COUNTY SURVEYOR
DOUGLAS COUNTY, ORE.

Corner Designation

CC
T22S R6W
S31|S52
56

- Condition Report Only
- Not Found
- Renewed
- Unrecorded
- Surveyed In
- Referenced Out

Previous Renewals/Surveys, etc. _____

Monument(s) & Accessories Found: (Condition and Source)


CORNER IS A GLO BRASS CAP WITH HAINES T-IRON ALONG SIDE.
CORNER IS LOOSELY SET IN ROCK
12" WF BEARS N60W 47.5 FT WELL HEALED FACE AND B.T. TAG

#121 T22-6
#56 T23-6

Reborn
Henlock

Monument Detail

Sketch

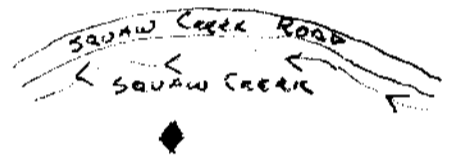

Monument Set (Procedures and Description)

New Accessories

PAINTED FACES AND WROTE B.T. ON TREE TRUNKS OF B.T.'S
WITH FLOUR ORANGE PAINT
PUT LONG ROCK TIMBER LOCATION TAG ON 6" DF BEARING N60°E
24.5 FT

Location & Comments

CORNER DES ON STEEP _____ Compass Declination 19 1/2°
 N. SLOPE NEAR ROCK FACE Firm/Agency LONG ROCK
 WITH PILE OF ROCKS AROUND TIMBER COMPANY
 CORNER AND HAINES T- _____ Address P.O. BOX 1127
 IRON ALONG SIDE SMALL ROSEBEC
 STAND OF 20-40" TIMBER Party Chief KEN W. HOFFINE
 TO THE NW AND SQUAW _____ Notes _____
 CREEK BEARS ABOUT APPROX _____ Witness GARY ANGIOLETT

Surveyor's Seal

REGISTERED
PROFESSIONAL
LAND SURVEYOR

Ken W. Hoffine

OREGON
JULY 10, 1987
KEN W. HOFFINE
2291

165 FT

#156 T22-6 X
#87 T23-6 X

C.S. File No. 63/127-5c